

LAND CORNER RECORDATION CERTIFICATE
Filing Requirement of Act 74, Mich. P.A. 1970

RECORDED

1999 NOV 10 AM 11:07

For corners in

Dickinson _____ Located In: _____ Corner Code # _____
 (County)

Sagola Twp. _____
 1. Public Land Survey T 43N R 30W _____ K-5 _____
 T _____ R _____
 T _____ R _____
 T _____ R _____

2. Property Controlling S _____ T _____ R _____
 in Section S _____ T _____ R _____

3. Miscellaneous S _____ T _____ R _____
 Property in Sec. S _____ T _____ R _____

4. Lot No. _____, Recorded Plat _____ SECTION _____
 5. Private Claims _____

REGISTER OF DEEDS
 DICKINSON COUNTY
 RON MOORE

Register of Deeds Stamp & File Number

	A	B	C	D	E	F	G	H	I	J	K	L	M
2	6	5	4	3	2	1							
3													
4	7	8	9	10	11	12							
5													
6	18	17	16	15	14	13							
7													
8	19	20	21	22	23	24							
9													
10	30	29	28	27	26	25							
11													
12	31	32	33	34	35	36							
13													

I, Edward Kazianka, in a field survey on October 21, 1999, do hereby certify that under requirements of P.A. 74, Michigan P.A. of 1970, the corner points mentioned in lines 1 and 2 above were in conformance with regulations and rules therefore as required in the current manual of survey instructions of the United States Department of the Interior, Bureau of Land Management or by a decree of a Court of Law and/or that the corner points mentioned in lines 3, 4 and 5 above were in conformance with the rules of the Michigan Board of Land Surveyors or by a Decree of a Court of Law; established, re-established, monumented, re-monumented, recovered, found as expressed below:

NOTE: Not more than 4 corners, all in the same town and range, may be recorded on this certificate.

A. Description of original monument and accessories and/or subsequent restoration:

K-5 Corner common to Sections 11-12-13-14.
 Post by John Burt, D.S. in 1846.
 Spruce 14 S34E 14 lks.
 Bk. Ash 6 N28E 23 lks.


B. Description of corner evidence found and/or method applied in restoring or reestablishing corner:

K-5 Found a one inch iron pipe and remains of old wood post. Witnesses to wood post used in 1965 survey by N. Sperhake, R.L.S. 7876, gone but two stumps at the proper distance and bearing from the pipe were found. Accepted the pipe as marking the corner location.

ACCEPTED BY THE DICKINSON COUNTY
 SURVEY PEER GROUP AS THE OFFICIAL
 CORNER UNDER MICHIGAN PUBLIC ACT
 345 OF 1990 AT A MEETING HELD ON
11-9-99
RON MOORE
 COUNTY REPRESENTATIVE

C. Description of monument for corner and accessories established to perpetuate locating the position of the corner:

K-5 Set 2½ inch Stamped D.C. Remon. Corner inside the one inch iron pipe.
 Cedar 10 N54E 49.95 feet. B. Ash 11 S64E 23.10 feet.
 Maple 8 S23W 43.62 feet. B. Ash 6 N80W 12.70 feet.
 Carsonite Marker North 2.5 feet.

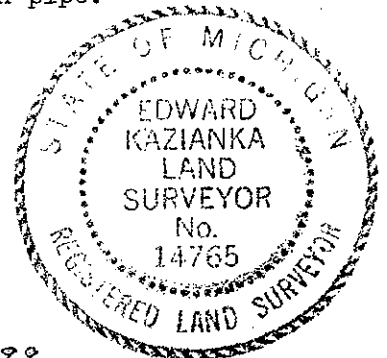

Signed by Edward Kazianka Date 11-10-99

Surveyor's Michigan License No. 14765