

MICHIGAN
DEPARTMENT OF CONSERVATION
FORESTRY DIVISION

LAND CORNER RECORD

T. 44 N.R. 27 W


Dickinson COUNTY

DESCRIPTION OF CORNER Section Corner common to Secs. 25, 26, 35, 36

CORNER MONUMENT 1" Pipe with 4" Aluminum Cap

DATE MONUMENT PLACED AND WITNESSED 9/15/64

WITNESSES TO CORNER..... 6" Jackpine (S35 NBT) S37°E, 71 Lks.

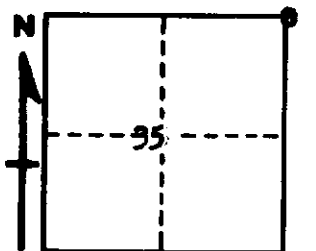

6" Jackpine (S26 NBT), N24°W, 49 Lks.

5" Jackpine (S25 NBT), N65°E, 66 Lks.

AND

Corner lies on South edge of a Jackpine Ridge, 1 chain North of Woods road.

DESCRIPTION IN DETAIL AS TO HOW CORNER WAS LOCATED AND IDENTIFIED OR RESTORED.

This Corner was replaced at squared Wood post set by unknown Surveyor. Position fits well with Section Corners one mile to North and South.

SURVEYOR'S SEAL

Billy D. Buckler.
SIGNED Billy D. Buckler DATE 9/29/64
REGISTERED LAND SURVEYOR