OK Bmc

LAND CORNER RECORDATION CERTIFICATE

Filing Requirement of Act 74, Mich. P.A. 1970

For corners in

Dickinson
(County)

	Located In:	Corner Code ##
1. Public Land Survey	T 44N R 27W	A-4.
	T ___ R ___	
	T ___ R ___	
	T ___ R ___	
2. Property Controlling	S 7 T 44N R 27W	10, 3.
in Section	S ___ T ___ R ___	
3. Miscellaneous	S ___ T ___ R ___	
Property in Sec.	S ___ T ___ R ___	

Register of Deeds Stamp & File Number

4. Lot No. _____, Recorded Plat _____
5. Private Claims _____

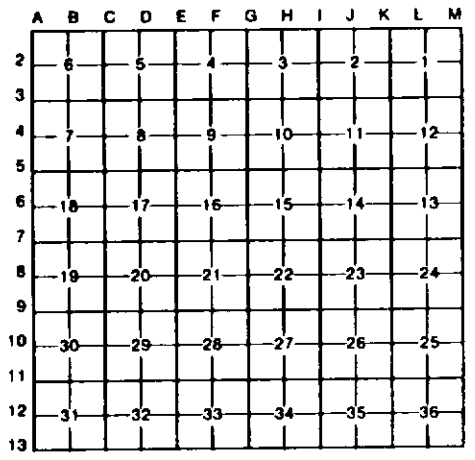

I, David Babbitt, in a field survey on 8/3/87, 19 ____, do hereby certify that under requirements of P.A. 74, Michigan P.A. of 1970, the corner points mentioned in lines 1 and 2 above were in conformance with regulations and rules therefore as required in the current manual of survey instructions of the United States Department of the Interior, Bureau of Land Management or by a decree of a Court of Law and/or that the corner points mentioned in lines 3, 4 and 5 above were in conformance with the rules of the Michigan Board of Land Surveyors or by a Decree of a Court of Law; established, re-established, monumented, re-monumented, recovered, found as expressed below:

NOTE: Not more than 4 corners, all in the same town and range, may be recorded on this certificate.

A. Description of original monument and accessories and/or subsequent restoration:

A-4. West 1/4 corner of Section 7. Wood post. Maple 8, S20W, 38 Lks.
Fir 7, N16E, 9 Lks.

10. South 1/16 corner on the west section line of Section 7. No previous record.

3. North 1/16 corner on the west section line of Section 7. No previous record.

B. Description of corner evidence found and/or method applied in restoring or reestablishing corner:

A-4. Set by single proportion to the GLO record using the section corner 1½ miles south and the twp. corner 1½ miles north.

10. Set MPOL between the west 1/4 corner and the SW section corner of Section 7.

3. Set MPOL between the west 1/4 corner and the NW section corner of Section 7.

C. Description of monument for corner and accessories established to perpetuate locating the position of the corner:

A-4. DNR Monument.
15" r.maple, N12W, 37.6'
10" r.maple, N57E, 53.0'
5" balsam fir, S40W, 21.7'
8" spruce, N85W, 25.1'
Corner is in easterly wheel track of old truck trail.

10. DNR Monument
20" spruce, N74W, 11.8'
6" spruce, N24E, 6.2'
12" w.pine, S33E, 30.4'
6" spruce, S12W, 27.9'

3. DNR Monument
12" r.maple, N45W, 26.7'
4" r.maple, N76E, 20.9'
8" r.maple, S30W, 24.9'
5" r.maple, S65W, 31.9'

Signed by David B. Babbitt Date 12-3-87

Surveyor's Michigan License No. 21558

FORM APPROVED BY MICHIGAN STATE BOARD OF LAND SURVEYORS, JAN. 28, 1971
REVISED MAY 14, 1975
REVISED JAN., 1983