

LAND CORNER RECORDATION CERTIFICATE
Filing Requirement of Act 74, Mich. P.A. 1970

For corners in

Dickinson

(County)

Located In:

Corner Code #

1. Public Land Survey	T <u>44N</u> R <u>27W</u>	<u>J2</u>
	T <u> </u> R <u> </u>	<u> </u>
	T <u> </u> R <u> </u>	<u> </u>
	T <u> </u> R <u> </u>	<u> </u>
2. Property Controlling in Section	S <u>2</u> T <u>44N</u> R <u>27W</u>	<u>9</u>
	S <u> </u> T <u> </u> R <u> </u>	<u> </u>
3. Miscellaneous Property in Sec.	S <u> </u> T <u> </u> R <u> </u>	<u> </u>
	S <u> </u> T <u> </u> R <u> </u>	<u> </u>

Register of Deeds Stamp & File Number

4. Lot No. _____, Recorded Plat _____
 5. Private Claims _____

9 Oct 16 2001
 J2 Oct 18 2001

I, Paul R. Bressette, in a field survey on _____, 20____ do hereby state that under requirements of P.A. 74, Michigan P.A. of 1970, the corner points mentioned in lines 1 and 2 above were in conformance with regulations and rules therefore as required in the current manual of survey instructions of the United States Department of the Interior, Bureau of Land Management or by a decree of a Court of Law and /or that the corner points mentioned in lines 3, 4 and 5 above were in conformance with the rules of the Michigan Board of Land Surveyors or by a Decree of a Court of Law; established, re-established, monumented, recovered, found as expressed below:

NOTE: Not more than 2 corners, all in the same town and range, may be recorded on this certificate.

A	B	C	D	E	F	G	H	I	J	K	L	M
1												
2	6	5	4	3					●	●	1	
3												
4	7	8	9	10	11	12						
5												
6	18	17	16	15	14	13						
7												
8	19	20	21	22	23	24						
9												
10	30	29	28	27	26	25						
11												
12	31	32	33	34	35	36						
13												

A. Description of original monument and accessories and/or subsequent restoration:


- (J2) Center Quarter corner of Section 2. Not set in original survey, no evidence of subsequent establishment.
- (9) East One-sixteenth corner of Section 2. Not set in original survey, no evidence of subsequent establishment.

B. Description of corner evidence found and/or method applied in restoring or reestablishing corner:

- (J2) Corner position established at the intersection of the north-south and east-west quarter lines of Section 2.
- (9) Corner position established mid-point and on-line between the Center and East Quarter corners of Section 2.

C. Description of monument for corner and accessories established to perpetuate locating the position of the corner:

- | | |
|--------------------------------|-----------------------------------|
| (J2) DNR monument | (9) DNR monument |
| 7" Spruce N77E 20.0' (1/4S,BT) | 24" W.Pine N30E 10.25' (1/16S,BT) |
| 8" Maple S47E 12.1' (1/4S,BT) | 13" W.Pine S60E 22.35' (1/16S,BT) |
| 8" Spruce S51W 15.8' (1/4S,BT) | 13" J.Pine S25W 54.5' (1/16S,BT) |
| 7" Spruce N17W 11.1' (1/4S,BT) | 11" W.Pine N41W 57.0' (1/16S,BT) |
- All trees are blazed, scribed and painted. Measurements are to nail in side of tree, bearings are magnetic.

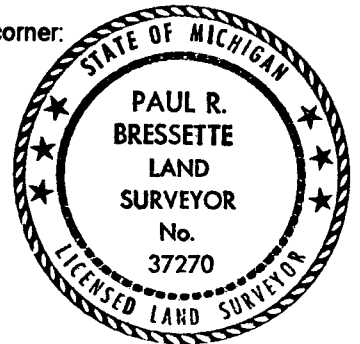

Signed by Paul R. Bressette
 Surveyor's Michigan License No. 37270

Date _____

For the Michigan Department of Natural Resources - Forest Management Division