LAND CORNER RECORDATION CERTIFICATE
Filing Requirement of Act 74, Mich. P.A. 1970 as Amended

For corners in

Dickinson
(County)

		Located In:		Corner Code #
1. Public Land Survey		T 44N	R 29W	K2
		T	R	
		T	R	
	S	T	R	
2. Property Controlling	S 1	T 44N	R 29W	6
in Section	S	T	R	
3. Miscellaneous	S	T	R	
Property in Sec.	S	T	R	

Register of Deeds Stamp & File Number

4. Lot No. _____ , Recorded Plat_____

5. Private Claims

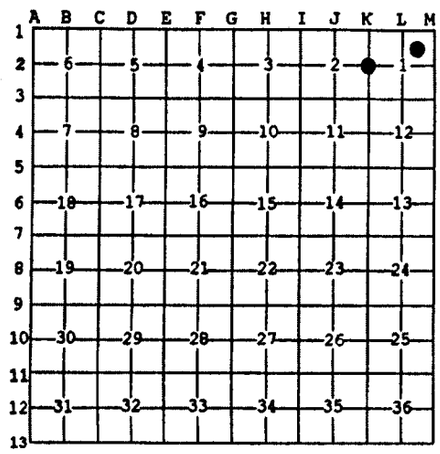

Jul 26 2005

I, Stephan J. Szyszkoski, in a field survey on _____, 20 ____ do hereby state that under requirements of P.A. 74, Michigan P.A. of 1970, the corner points mentioned in lines 1 and 2 above were in conformance with regulations and rules therefore as required in the current manual of survey instructions of the United States Department of the Interior, Bureau of Land Management or by a decree of a Court of Law and /or that the corner points mentioned in lines 3, 4 and 5 above were in conformance with the rules of the Michigan Board of Land Surveyors or by a Decree of a Court of Law; established, re-established, monumented, recovered, found as expressed below:

NOTE: Not more than 2 corners, all in the same town and range, may be recorded on this certificate.

A. Description of original monument and accessories and/or subsequent restoration:

(K2) Quarter corner common to Sections 1 and 2. 1848 - Established by John Burt: South Corrected between 1 & 2 ...41.27 Set W.Birch Qr. Sect. post. W.Pine 28 N24E 48 links, W.Pine 24 N35W 40 links. ...81.27 Section corner.
(6-Sec. 1) Northeast 1/16 corner Section 1. Not established in the original survey.

B. Description of corner evidence found and/or method applied in restoring or reestablishing corner:

(K2) The original post and accessories were not recovered. Found no evidence of subsequent perpetuation on the ground. Reestablished the corner by single proportionate measurement to the original record on a straight line between Section corners of record 2646.17' South and 2730.18' North.
(6-Sec. 1) Established the corner at the intersection of straight lines connecting opposite 1/16 corners.

C. Description of monument for corner and accessories established to perpetuate locating the position of the corner:

(K2) Set 1"IDx32" I.pipe with 4" alum. MDNR cap. Set measuring nails in:
4" Tamarack S02E 13.9' mrkd "1/4S NBT"
3" B.Spruce S69W 12.1' do
5" B.Spruce N86W 18.5' do
13" B.Spruce N35W 3.26' do
Set sq'd cedar post adjacent. Bearings are magnetic. Distances are to nail with tag.

(6) Set 1"IDx32" I.pipe with 4" alum. MDNR cap. Set measuring nails in:
11" Maple N58E 25.9' mrkd "1/16S BT"
9" Maple S02E 24.6' do
9" Maple S58W 24.0' do
9" Maple in clump N56W 14.8' do
Set sq'd cedar post adjacent. Bearings are magnetic. Distances are to nail with tag.

STATE OF MICHIGAN
STEPHAN J. SZYSZKOSKI
LAND SURVEYOR
No. 33986
LICENSED LAND SURVEYOR

Signed by Stephen J. Szyszkoski Date 9/29/05

Surveyor's Michigan License No. 33986

For the Michigan Department of Natural Resources, Office of Land and Facilities

FORM APPROVED BY MICHIGAN STATE BOARD OF PROFESSIONAL SURVEYORS, JAN. 28, 1971
Revised May 14, 1975
Revised Jan., 1983
Rervised Oct., 1995