LAND CORNER RECORDATION CERTIFICATE
Filing Requirement of Act 74, Mich. P.A. 1970 as Amended

For corners in

Dickinson
(County)

		Located In:		Corner Code #
1. Public Land Survey		T 44N	R 29W	L3
		T____	R____	
		T____	R____	
	S____	T____	R____	
2. Property Controlling	S____	T____	R____	
in Section	S____	T____	R____	
3. Miscellaneous	S____	T____	R____	
Property in Sec.	S____	T____	R____	

Register of Deeds Stamp & File Number

4. Lot No. _____ , Recorded Plat_____
5. Private Claims

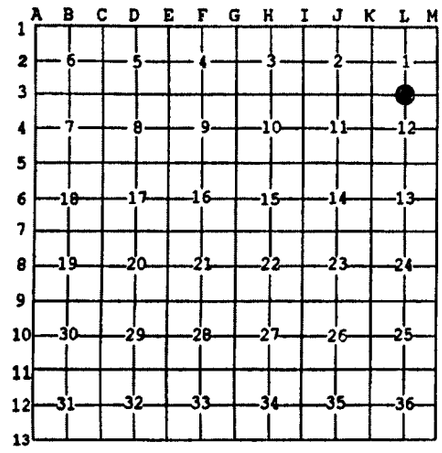

Jul 07 2005

I, Stephan J. Szyszkoski, in a field survey on _____, 20 ____ do hereby state that under requirements of P.A. 74, Michigan P.A. of 1970, the corner points mentioned in lines 1 and 2 above were in conformance with regulations and rules therefore as required in the current manual of survey instructions of the United States Department of the Interior, Bureau of Land Management or by a decree of a Court of Law and /or that the corner points mentioned in lines 3, 4 and 5 above were in conformance with the rules of the Michigan Board of Land Surveyors or by a Decree of a Court of Law; established, re-established, monumented, recovered, found as expressed below:

NOTE: Not more than 2 corners, all in the same town and range, may be recorded on this certificate.

A. Description of original monument and accessories and/or subsequent restoration:

(L3) Quarter corner common to Sections 1 and 12. 1848 - Established by John Burt: West marked line between 1 & 12 ...39.92 Set Y.Birch Qr. Sect. post. Sugar 14 N75E 40 links. Maple 5 S45W 24 links. ...79.84 Section corner.

B. Description of corner evidence found and/or method applied in restoring or reestablishing corner:

(L3) The original post and accessories were not recovered. Found no evidence of subsequent perpetuation on the ground. Reestablished the corner midway and on the Section line between Section corner 2648.00' East and West.

C. Description of monument for corner and accessories established to perpetuate locating the position of the corner:

(L3) Set 1"IDx32" I.pipe with 4" alum.
MDNR cap. Set measuring nails in:
10" Oak N16E 16.8' mrkd "1/4S N8T"
15" Oak S78E 25.9' do
5" Maple S21W 22.0' do
22" Oak S70W 19.7' do
Set sq'd spruce post adjacent. Bearings are magnetic. Distances are to nail with tag.

STATE OF MICHIGAN
STEPHAN J. SZYSZKOSKI
LAND SURVEYOR
No. 33986
LICENSED LAND SURVEYOR

Signed by Stephan J. Szyszkoski Date 9/29/05

Surveyor's Michigan License No 33986

For the Michigan Department of Natural Resources, Office of Land and Facilities

FORM APPROVED BY MICHIGAN STATE BOARD OF PROFESSIONAL SURVEYORS, JAN. 28, 1971
Revised May 14, 1975
Revised Jan., 1983
Rervised Oct., 1995