

MICHIGAN  
DEPARTMENT OF CONSERVATION  
FORESTRY DIVISION

LAND CORNER RECORD

45N 29 W  
T. 44. NR. 29 W.

----- Dickinson ----- COUNTY

DESCRIPTION OF CORNER 1/4 Section Corner on North side of Section 5,  
between 5-32

DESCRIPTION OF CORNER MONUMENT 1" pipe with 4" brass cap.

WITNESSES TO CORNER 20" White Pine Stp. S 7° E 59 links

16" White Pine Stp. N 53° E 95 links

DESCRIPTION IN DETAIL AS TO HOW CORNER WAS LOCATED AND IDENTIFIED OR RESTORED.

Replaced 1/4 Section Corner on North side 5.


Two White Pine stps. and traces of stake in soil in proper position.

This 1/4 Corner found by Survey Crew while running lines in this vicinity.

There is an erroneous 1/4 corner set about 5 chs. North of here. Set by D. Ferneti.

Corner placed and witnessed October 9, 1955.

SURVEYORS SEAL

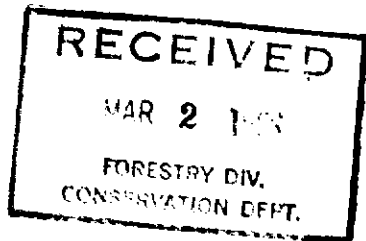

SIGNED Billy D. Buckles  
REGISTERED LAND SURVEYOR

DATE 2/27/56