

**SURVEY &
REMONUMENTATION**

DEC 18 1995

COMMISSION

RECORDED

LAND CORNER RECORDATION CERTIFICATE 85 NOV -7 AM 9:23
Filing Requirement of Act 74, Mich. P.A. 1970

For corners in

Dickinson
(County)

Located In: _____ Corner Code # _____

1. Public Land Survey T 44N R 30W I-9 & J-9
T _____ R _____
T _____ R _____
T _____ R _____

2. Property Controlling S _____ T _____ R _____
in Section S _____ T _____ R _____

3. Miscellaneous S _____ T _____ R _____
Property in Sec. S _____ T _____ R _____

4. Lot No. _____, Recorded Plat _____

5. Private Claims _____

REGISTER OF DEEDS
DICKINSON COUNTY
85 NOV -7 AM 9:23

Register of Deeds Stamp & File Number

I, Edward Kazianka, in a field survey on July 10, 19 95
do hereby certify that under requirements of P.A. 74, Michigan P.A. of 1970, the corner points mentioned
in lines 1 and 2 above were in conformance with regulations and rules therefore as required in the
current manual of survey instructions of the United States Department of the Interior, Bureau of Land
Management or by a decree of a Court of Law and/or that the corner points mentioned in lines 3, 4 and 5
above were in conformance with the rules of the Michigan Board of Land Surveyors or by a Decree of a
Court of Law; established, re-established, monumented, re-monumented, recovered, found as
expressed below:

**NOTE: Not more than 4 corners, all in the same town and range, may be recorded
on this certificate.**

A. Description of original monument and accessories and/or subsequent restoration:

I-9 Wood Post Cedar 18 S30W 12 lks. Lynn 24 N60E 15 lks.
3/4 inch iron pin set by persons unknown.

J-9 Wood Post. Tamarack 18 S46E 40 lks. Cedar 10 N65W 49 lks.
Dept. of Conservation Brass cap and pipe.
Cedar 10 S80W 06 lks. Stump of Tam. B.T. S46E 40 lks.
" 8 N20E 17 lks.

B. Description of corner evidence found and/or method applied in restoring or reestablishing corner:

I-9 3/4 inch by 36 inch iron pin.
J-9 Dept. of Con. cap and pipe.


C. Description of monument for corner and accessories established to perpetuate locating the position of the corner:

I-9 Set a Dickinson County Survey cap/rod in place of the 3/4 inch iron pin.
Maple 7 N42W 41.45 feet. Maple 8 N68E 29.70 feet.
" 8 S24E 54.40 feet. " 9 S18W 41.20 feet.

J-9 Dept. of Con. Brass cap and pipe.
Cedar 16 N31E 11.40 feet. Cedar 6 N58W 7.30 feet.
" 12 S88W 5.05 feet. " 12 S18E 18.95 feet.
3 inch iron pipe S14W 2.70 feet.

	A	B	C	D	E	F	G	H	I	J	K	L	M
2	6	5	4	3	2	1							
3													
4	7	8	9	10	11	12							
5													
6	18	17	16	15	14	13							
7													
8	19	20	21	22	23	24							
9													
10	30	29	28	27	26	25							
11													
12	31	32	33	34	35	36							
13													

ACCEPTED BY THE DICKINSON COUNTY
SURVEY PEER GROUP AS THE OFFICIAL
CORNER UNDER MICHIGAN PUBLIC ACT
345 OF 1980 AT A MEETING HELD ON
11-6-95
RJP
COUNTY REPRESENTATIVE

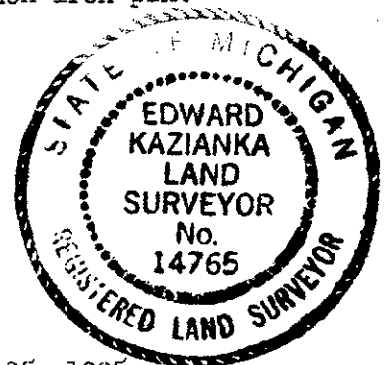

Signed by Edward Kazianka

Date August 25, 1995

Surveyor's Michigan License No. 14765