

SURVEY & REMONUMENTATION

DEC 18 1995

COMMISSION

LAND CORNER RECORDATION CERTIFICATE 1995 NOV -7 AM 9:23
Filing Requirement of Act 74, Mich. P.A. 1970

RECORDED

For corners in

Dickinson (County) Located In: _____ Corner Code # K-7 & K-8

1. Public Land Survey T DLN R 30W
T _____ R _____
T _____ R _____
T _____ R _____

2. Property Controlling S _____ T _____ R _____
in Section S _____ T _____ R _____

3. Miscellaneous S _____ T _____ R _____
Property in Sec. S _____ T _____ R _____

4. Lot No. _____, Recorded Plat _____

5. Private Claims _____

REG. OFFICE OF DEEDS
DICKINSON COUNTY
301 W. ...

Register of Deeds Stamp & File Number

	A	B	C	D	E	F	G	H	I	J	K	L	M
2	6	5	4	3	2	1							
3													
4	7	8	9	10	11	12							
5													
6	18	17	16	15	14	13							
7													
8	19	20	21	22	23	24							
9													
10	30	29	28	27	26	25							
11													
12	31	32	33	34	35	36							
13													

I, Edward Kazianka, in a field survey on July 10, 19 95, do hereby certify that under requirements of P.A. 74, Michigan P.A. of 1970, the corner points mentioned in lines 1 and 2 above were in conformance with regulations and rules therefore as required in the current manual of survey instructions of the United States Department of the Interior, Bureau of Land Management or by a decree of a Court of Law and/or that the corner points mentioned in lines 3, 4 and 5 above were in conformance with the rules of the Michigan Board of Land Surveyors or by a Decree of a Court of Law; established, re-established, monumented, re-monumented, recovered, found as expressed below:

NOTE: Not more than 4 corners, all in the same town and range, may be recorded on this certificate.

A. Description of original monument and accessories and/or subsequent restoration:

K-7 Wood Post Tamarack 10 S44W 50 lks. W. Pine 10 N41E 40 lks.

3/4 inch iron pin on east slope of M-95, probably set by highway survey crew.

K-8 Wood Post Cedar 10 S36E 03 lks. Cedar 12 N11W 16 lks.

Dept. of Conservation Brass cap and pipe.
Maple 3 S27E 10 lks. W. Birch 9 N52E 25 lks.

B. Description of corner evidence found and/or method applied in restoring or reestablishing corner:

K-7 3/4 inch iron pin.

K-8 Dept. of Con. pipe and cap. W. Birch B.T. dead but Maple B.T. still alive.

ACCEPTED BY THE DICKINSON COUNTY SURVEY PEER GROUP AS THE OFFICIAL CORNER UNDER MICHIGAN PUBLIC ACT 345 OF 1990 AT A MEETING HELD ON

11-6-95
ROP

COUNTY REPRESENTATIVE


C. Description of monument for corner and accessories established to perpetuate locating the position of the corner:

K-7 Set a Dickinson County Survey cap/rod in place of the 3/4 inch iron pin:

Aspen 7 S81E 53.25 feet. R. Pine 8 S08E 96.95 feet.
" 8 S35W 131.20 feet. Spruce 6 N49W 189.0 feet.

K-8 Dept. of Con. Brass cap and pipe.

Maple 6 S27E 6.95 feet. Maple 12 S39W 47.80 feet.
" 6 N66W 3.75 feet. W. Birch 10 S59E 13.15 feet.

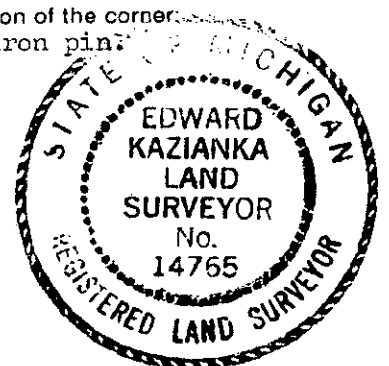

Signed by Edward Kazianka
Surveyor's Michigan License No. 14765

Date August 25, 1995

172