

**SURVEY &  
REMONUMENTATION**

FILED

copy

APR 27 1995

94 OCT 26 AM 8:57

**COMMISSION**

**LAND CORNER RECORDATION CERTIFICATE**  
Filing Requirement of Act 74, Mich. P.A. 1970

LINDA M. TWITCHELL  
REGISTER OF DEEDS  
EATON COUNTY, MICH.

For corners in

EATON (County) Located In: Corner Code ##

HAMLIN TOWNSHIP

1. Public Land Survey T 1N R 3W B-1

T \_\_\_\_\_ R \_\_\_\_\_

T \_\_\_\_\_ R \_\_\_\_\_

T \_\_\_\_\_ R \_\_\_\_\_

2. Property Controlling S \_\_\_\_\_ T \_\_\_\_\_ R \_\_\_\_\_

in Section S \_\_\_\_\_ T \_\_\_\_\_ R \_\_\_\_\_

3. Miscellaneous S \_\_\_\_\_ T \_\_\_\_\_ R \_\_\_\_\_

Property in Sec. S \_\_\_\_\_ T \_\_\_\_\_ R \_\_\_\_\_

4. Lot No. \_\_\_\_\_, Recorded Plat \_\_\_\_\_

5. Private Claims \_\_\_\_\_

LIBER 3 PAGE 111

Register of Deeds Stamp & File Number

I, David Clifford, in a field survey on July 24, 19 94, do hereby certify that under requirements of P.A. 74, Michigan P.A. of 1970, the corner points mentioned in lines 1 and 2 above were in conformance with regulations and rules therefore as required in the current manual of survey instructions of the United States Department of the Interior, Bureau of Land Management or by a decree of a Court of Law and/or that the corner points mentioned in lines 3, 4 and 5 above were in conformance with the rules of the Michigan Board of Land Surveyors or by a Decree of a Court of Law; established, re-established, monumented, re-monumented, recovered, found as expressed below:

	A	B	C	D	E	F	G	H	I	J	K	L	M
2	6	5	4	3	2	1							
3													
4	7	8	9	10	11	12							
5													
6	18	17	16	15	14	13							
7													
8	19	20	21	22	23	24							
9													
10	30	29	28	27	26	25							
11													
12	31	32	33	34	35	36							
13													

NOTE: Not more than 4 corners, all in the same town and range, may be recorded on this certificate.

A. Description of original monument and accessories and/or subsequent restoration:

1. Corner not set in original government surveys.
2. A.N. Bateman, Co. Surveyor reported setting this corner in a survey in Nov. 1894, recorded in a volume labeled "Surveyors Record" with no mention of monument or witnesses but an implied relationship to the N.W. and N.E. corners of the Section.


(OVER)

B. Description of corner evidence found and/or method applied in restoring or reestablishing corner:

Searched at apparent location of corner and found 1/2" Bar & Cap #18988 2 foot South of East-West fence line. Traversed Section 6, T1N,R3W, closing on Ron Helsel's traverse of Section 31, T2N,R3W, and found that found iron is on the Township line and appears to have been set based on proration of Batemans 1894 survey. Extended 1/4 line fence, which ends on Five Point Highway about 300 feet South of Corner, and hit Found Bar & Cap. Accepted Found Bar & Cap as corner and replaced with Standard Bar & Cap. Measured East 2659.15' to C-1. Measured West 2566.13 to A-1

C. Description of monument for corner and accessories established to perpetuate locating the position of the corner:

3/4" Bar and PA 345 Cap PS 25837  
 Found Accolade Nail & Tag in S. side 4" Cherry NAZ 277° 6.83'  
 Found Accolade Nail & Tag in S. side 6" Cherry NAZ 278° 9.25'  
 Found Fluke Nail & Tag in S. side fence post NAZ 86° 4.08'  
 Found Nail & Tag # 28409 (Ron Enger) in S. Side 18" Cherry NAZ 90° 41.10'  
 Found Nail & Tag # 28409 in E. side 7" Cherry NAZ 185° 5.87'  
 3/4" Bar and PA 345 Cap PS 18994 (Ron Helsel) S 1/4 Cor. Sec. 31 T2N,R3W NAZ 270° 59.01'

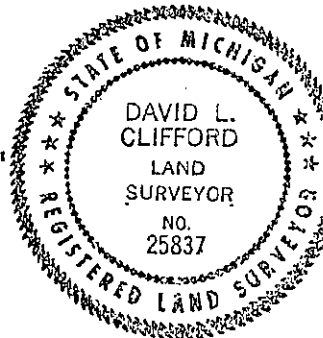

Signed by David Clifford Date July 26, 1994

Surveyor's Michigan License No. 25837

FORM APPROVED BY MICHIGAN STATE BOARD OF LAND SURVEYORS, JAN. 28, 1971  
 REVISED MAY 14, 1975  
 REVISED JAN., 1983

P.A. 345 EATON COUNTY  
 PEER APPROVED 7/27/94

3. K. Don Fluke L.S. # 18988 reported setting corner in an unrecorded retracement survey of section 6 with no mention of monument or witnesses. This Survey was performed in April 1992