

**SURVEY &
REMONUMENTATION**

APR 27 1995

COMMISSION

FILED

copy

94 OCT 26 AM 8:58

**LAND CORNER RECORDATION CERTIFICATE
Filing Requirement of Act 74, Mich. P.A. 1970**

For corners in

LINDA M. TWITCHELL
REGISTER OF DEEDS
EATON COUNTY, MICH.

<u>EATON</u> <small>(County)</small>	Located In:	Corner Code #
1. <u>HAMLIN TOWNSHIP</u> Public Land Survey	T <u>1N</u> R <u>3W</u>	<u>C-5</u>
	T _____ R _____	_____
	T _____ R _____	_____
	T _____ R _____	_____
2. Property Controlling in Section	S _____ T _____ R _____	_____
	S _____ T _____ R _____	_____
3. Miscellaneous Property in Sec.	S _____ T _____ R _____	_____
	S _____ T _____ R _____	_____

LIBER 3 PAGE 275

Register of Deeds Stamp & File Number

4. Lot No. _____, Recorded Plat _____
5. Private Claims _____

	A	B	C	D	E	F	G	H	I	J	K	L	M
2	6		5		4		3		2		1		
3													
4	7		8		9		10		11		12		
5													
6	18		17		16		15		14		13		
7													
8	19		20		21		22		23		24		
9													
10	30		29		28		27		26		25		
11													
12	31		32		33		34		35		36		
13													

I, David Clifford, in a field survey on July 23, 1994, do hereby certify that under requirements of P.A. 74, Michigan P.A. of 1970, the corner points mentioned in lines 1 and 2 above were in conformance with regulations and rules therefore as required in the current manual of survey instructions of the United States Department of the Interior, Bureau of Land Management or by a decree of a Court of Law and/or that the corner points mentioned in lines 3, 4 and 5 above were in conformance with the rules of the Michigan Board of Land Surveyors or by a Decree of a Court of Law; established, re-established, monumented, re-monumented, recovered, found as expressed below:

NOTE: Not more than 4 corners, all in the same town and range, may be recorded on this certificate.

A. Description of original monument and accessories and/or subsequent restoration:

1. Original Post set by Hervey Parke DS in Jan. 1826
Tam 9 N23 $\frac{1}{2}$ °W 20
Aspen 10 S3°E 156
2. W.H. Bailey Co. Surveyor called for corner as a stone in a Survey Dated Feb 1884 recorded in Vol. 2 Page 111 Co. Surveyor records.

(OVER)


B. Description of corner evidence found and/or method applied in restoring or reestablishing corner:

Searched at apparent location of Corner and found $\frac{1}{2}$ " rebar 3' North Of Centerline Nye Highway on Fence Line North and on approximate Centerline of Peck Road. Tied Occupation Lines West, South and East to determine excavation and excavated 6'X6' Hole through 4.5' of road gravel to natural ground(Dry Black Muck). Found nothing more. Accepted $\frac{1}{2}$ " Rebar as perpetuation of corner and replaced it with Standard Bar & Cap. Measured North 2648.72 to C-4, West 2656.86 to B-5

C. Description of monument for corner and accessories established to perpetuate locating the position of the corner:

Standard 3/4" Bar & PA 345 Cap PS 25837

- Found Nail & Tag 3276 in E. Side Power Pole NAZ 61° 58.85'
- Found Nail & Tag 3276 in South Side 28" Pople NAZ 312° 100.40'
- Set Nail & Tag 25837 in Top S.E'ly Bridge Guard Rail Post NAZ 259° 139.25'
- Set Nail & Tag 25837 in SW Side 18" Willow NAZ 129° 70.50'
- Centerline South End 18" CMP NAZ 130° 38.00'

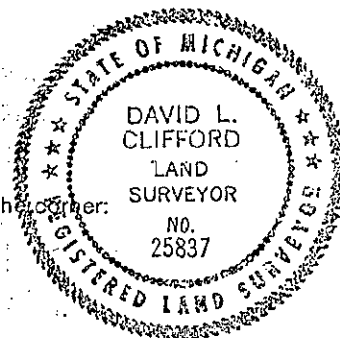

Signed by David L. Clifford

Date July 26, 1994

Surveyor's Michigan License No. 25837

FORM APPROVED BY MICHIGAN STATE BOARD OF LAND SURVEYORS, JAN. 28, 1971
REVISED MAY 14, 1975
REVISED JAN., 1983

P.A. 345 EATON COUNTY
PEER APPROVED 7/27/94 *mc*

3. L. Hendryx LS 3276 recorded corner in Liber 1 Of Corners Page 142 in July 1972 as a #5 iron set.
#4 iron 33' North
Center Power Pole SW 31.0'