

**SURVEY &
REMONUMENTATION**

DEC 13 1999

FILED

Copy

99 NOV 12 AM 8:18

SECTION

**LAND CORNER RECORDATION CERTIFICATE
Filing Requirement of Act 74, Mich. P.A. 1970**

For corners in HAMLIN TOWNSHIP

EATON COUNTY Located In: Corner Code #

1. Public Land Survey T 1N R 3W K-9
T R
T R
T R

2. Property Controlling S T R
in Section S T R

3. Miscellaneous S T R
Property in Sec. S T R

LINDA M. TWITCHELL
REGISTER OF DEEDS
EATON COUNTY, MICH.

LIBER 4 PAGE 77
Register of Deeds Stamp & File Number

4. Lot No. _____, Recorded Plat _____
5. Private Claims _____

I, Maurice H. Mahieu, in a field survey on October 5, 1999, do hereby state that under requirements of P.A. 74, Michigan P.A. of 1970, the corner points mentioned in lines 1 and 2 above were in conformance with regulations and rules therefore as required in the current manual of survey instructions of the United States Department of the Interior, Bureau of Land Management or by a decree of a Court of Law and /or that the corner points mentioned in lines 3, 4 and 5 above were in conformance with the rules of the Michigan Board of Land Surveyors or by a Decree of a Court of Law; established, re-established, monumented, recovered, found as expressed below:

NOTE: Not more than 2 corners, all in the same town and range, may be recorded on this certificate.

A. Description of original monument and accessories and/or subsequent restoration:

- Original corner set by Hervey Parkes D.S. in 1826 at a distance of 80.00 chains from K-11. "Set post cor secs 23, 24, 25, 26. Maple 12 N 1° W 28. Double Maple 8 S 20° W 21."
- Volume 4, Page 24 of County Surveyor's records shows a survey by Morrell E. Newcomb, County Surveyor on May 25, 1907 in which the corner is identified as a stone. Corner measured 2649.26' from L-9.
- H.A. Williams, County Surveyor, records finding the Government Stake and setting a 2 1/2" x 4' steel shaft in margin notes in G.L.O records dated 1922. The same set of margin notes has the word "stone" written directly over them in different handwriting. Witnesses: Maple 26 N 60° E 39'. Elm 15 S 3 1/2° E 39.3'. Triple Maple S 39 1/2° W 44.3'.

(Continued on Back)

B. Description of corner evidence found and/or method applied in restoring or reestablishing corner:

Found a highly oxidized and slightly deformed 3/4" pipe in a monument box in the centerline of Bellevue Hwy. Found witnesses: Nail and Tag #28414 S. side Utility Pole N 65° W 89.58', Nail and Tag #28414 N side 36" Oak S 70° W 78.81', Nail and Tag #28414 NW side Maple Clump S 50° W 58.66', and SE Corner House Block Foundation N 40° E 120.91'. All old witnesses in A-4 have been removed. Bellevue Hwy. In a ±3' fill area at the found pipe. Excavated a 2' x 2' x 3.5' pit. Encountered original gravel road surface ±2' below asphalt surface. Encountered old road bed (dark clay soil) ±0.5' below original gravel road surface. Continued digging 1.00' deeper. Found no evidence of prior monumentation. Swept the bottom of the pit with a magnetic locator; no indication of the 2 1/2" x 4' shaft described in A.3. above. Accepted location of 3/4" pipe as perpetuated position of corner based on previous surveyor's work. Removed 3/4" pipe and set 3/4" x 24" iron form pin with a 2 1/2" diameter aluminum P.A. 345 cap #28414.


C. Description of monument for corner and accessories established to perpetuate locating the position of the corner:

3/4" x 24" iron form pin and a 2 1/2" diameter aluminum P.A. 345 cap #28414 in a monument box witnessed by:
Nail and Tag #28414 S. side Utility Pole N 65° W 89.58'.
Nail and Tag #28414 N. side 36" Oak S 70° W 78.81'.
Nail and Tag #28414 NW side Maple Clump S 50° W 58.66'.
SE Corner House Block Foundation N 40° E 120.91'.

Signed by Maurice Mahieu Date 10-19-99
Surveyor's Michigan License No. 28414

	A	B	C	D	E	F	G	H	I	J	K	L	M
1													
2	6		5		4		3		2		1		
3													
4	7		8		9		10		11		12		
5													
6	16		17		16		15		14		13		
7													
8	19		20		21		22		23		24		
9													
10	30		29		28		27		26		25		
11													
12	31		32		33		34		35		36		
13													

P.A. 345 EATON COUNTY
PEER APPROVED 10/12/99 RL

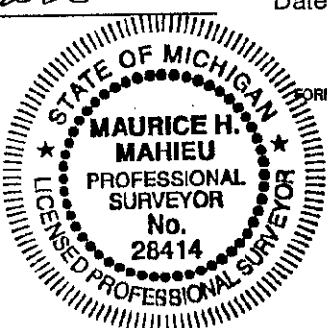

FORM APPROVED BY MICHIGAN STATE BOARD OF PROFESSIONAL SURVEYORS, JAN. 28, 1971
REVISED MAY 14, 1975

REVISED JAN, 1983
REVISED OCT, 1995

A. (CONTINUED) 999 EVLOR CORP.

4. An Act 132 survey recorded in Liber 1, Page 682 by Ron Helsel R.L.S. #18994 on August 19, 1973 identifies the corner as a found 3/4" iron pipe. Corner measured 2660.50' from L-9. Witnesses: "N 43° W, 88.21 ft., Nail and Cap East side Power Pole S 45° W, 79.80 ft., Nail and Cap North side 28" Maple, N 55° E, 91.04 ft., Nail and Cap South side 20" Maple."
5. An Act 132 survey recorded in Liber 2, Page 501 by Ronnie M. Lester R.L.S. #18998 on December 23, 1977 identifies corner as found 1/2" pipe measuring 2658.44' from L-9. Witnesses same as in A.4. above.
6. An Act 132 survey recorded in Liber 2, Page 958 by Ronnie M. Lester R.L.S. #18998 on June 26, 1979 has same measurement and witnesses as in A.5. above; monumentation not mentioned.
7. An Act 132 survey recorded in Liber 3, Page 297 by Ronnie M. Lester L.S. #18998 on April 17, 1981 has same measurement and witnesses as in A.5. above. Monumentation not mentioned.
8. An Act 132 survey recorded in Liber 3, Page 536 by Austin C. Williams R.L.S. #21275 on April 11, 1983 has same witnesses as in A.5. above. Monumentation and measurement not given.
9. An Act 132 survey recorded in Liber 4, Page 79 by Fred N. White R.L.S. #12034 on August 12, 1985 indicates he measured the corner 2658.37' from L-9. Monumentation and witnesses not given.
10. A L.C.R.C. recorded in Liber 3, Page 180 by Larry A. Bryan L.L.S. #25832 on January 17, 1992 identifies corner as a found 1/2" pipe with the same witnesses as in A.4. above.
11. An Act 132 survey recorded in Liber 8, Page 751 by Anthony Bumstead P.S. #41095 on September 1, 1999 identifies the corner as a found 1/2" pipe. Witnesses same as in A.4. above. Corner measured 2658.48' from L-9.

SURVEY &
REMONUMENTATION

DEC 19 1999

SECTION