

**SURVEY &
REMONUMENTATION**

OCT 16 1993

LAND CORNER RECORDATION CERTIFICATE
Filing Requirement of Act 74, Mich. P.A. 1970

LIBER 3 PAGE 259

COMMISSION
For corners in

FILED
Copy

93 OCT -7 AM 9:09

LINDA M. TWITCHELL
REGISTER OF DEEDS
EATON COUNTY, MICH.

Register of Deeds Stamp & File Number

<u>EATON COUNTY</u> (County)	Located In:	Corner Code #
1. Public Land Survey	T <u>1N</u> R <u>4W</u>	<u>A-5</u>
Brookfield Township	T _____ R _____	_____
	T _____ R _____	_____
	T _____ R _____	_____
2. Property Controlling in Section	S _____ T _____ R _____	_____
	S _____ T _____ R _____	_____
3. Miscellaneous Property in Sec.	S _____ T _____ R _____	_____
	S _____ T _____ R _____	_____
4. Lot No. _____, Recorded Plat _____		
5. Private Claims _____		

A	B	C	D	E	F	G	H	I	J	K	L	P
2	6	5	4	3	2	1						
3												
4	7	8	9	10	11	12						
5												
6	18	17	16	15	14	13						
7												
8	19	20	21	22	23	24						
9												
10	30	29	28	27	26	25						
11												
12	31	32	33	34	35	36						
13												

I, David R. Lohr, in a field survey on May 26, 19 93, do hereby certify that under requirements of P.A. 74, Michigan P.A. of 1970, the corner points mentioned in lines 1 and 2 above were in conformance with regulations and rules therefore as required in the current manual of survey instructions of the United States Department of the Interior, Bureau of Land Management or by a decree of a Court of Law and/or that the corner points mentioned in lines 3, 4 and 5 above were in conformance with the rules of the Michigan Board of Land Surveyors or by a Decree of a Court of Law; established, re-established, monumented, re-monumented, recovered, found as expressed below:

NOTE: Not more than 4 corners, all in the same town and range, may be recorded on this certificate.

A. Description of original monument and accessories and/or subsequent restoration:

- A-5 1. Corner marked on 10" Lynn by Sylvester Sibley, Deputy Surveyor, 1825. Witnessed by post M-9 Walton Twp. North 91 Links (60.06'),
- 2. No other references found in County Surveyors Records.
- 3. Corner re-set by pro-rated Government measure by William Byl, P.S. #23502, on 5/7/82, Liber 2 Page 812, "set 1/2" re-rod and cap in Nye Hwy. " Witnessed by: Nail E/S MBT pole SW 97.50' NE corner Sec. 13, M-5 North 60.3 (Walton) Nail W/S Power pole SSE 70.40' C/L top MBT pedestal NE 39.90' C/L street sign post ESE 44.3'
- 4. Private Surveyor's records reveal no additional data. (OVER)

B. Description of corner evidence found and/or method applied in restoring or reestablishing corner:

- A-5 Found 1/2" iron with cap in Nye Road as recorded by William R. Byl on Liber 2, Page 812 This corner is accepted as a careful and faithful re-establishment of the position of the original corner.

No excavation conducted at this location. Corner is in existing monument box in Cochran Road. Cochran Road is paved.


C. Description of monument for corner and accessories established to perpetuate locating the position of the corner:

- A-5 Left 1/2" iron with cap in centerline of Nye Hwy, and accepted as a careful and faithful re-establishment of the position of the original corner. Witnessed by: Set galv. nail/tag #30090 SW/S of 12" Elm Az. 314° 105.69' Set galv. nail/tag #30090 NE/S of 40" Oak Az. 282° 150.14' Set galv. nail and tag #30090 SW/S of Power Pole Az. 158° 68.00' Set galv. nail/tag #30090 NW/S Power pole Az. 230° 97.56' M-5 Walton iron/cap #23502 in Mon. box Az. 0° 60.35'

Signed by David R. Lohr
Surveyor's Michigan License No. 30090

Date August 6, 1993

P.A. 345 EATON COUNTY
PEER APPROVED 9/16/93

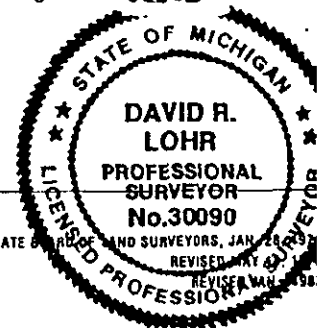

1.0103

A. CONTINUED

- A-5. . Sketch and data provided by Wm. Byl shows that M-5 (Walton Township) was set midway and on line between M-3 and M-7. Measurements of 5303.40' taken in both directions. Based on the data provided by Byl it is presumed that a proportioning factor of 1.004 was applied to the recorded Gov't distance of 91 links (60.06') by dividing the meas. distance South between M-5 and M-7 of 5303.4' by the recorded Gov't measure of 5280' (80 chains). The result is the factor 1.004 which when applied to the recorded closing distance of 60.06' gives the applied distance of 60.30', which Byl used when setting A-5. The iron was set on line between M-5 (Walton) and M-7 (Walton).