

SURVEY &  
REMONUMENTATION

OCT 16 1993

COMMISSION

LAND CORNER RECORDATION CERTIFICATE  
Filing Requirement of Act 74, Mich. P.A. 1970

LIBER 3 PAGE 263  
FILED  
Copy

For corners in

<u>EATON COUNTY</u> (County)	Located In:	Corner Code #
Brookfield Township		
1. Public Land Survey	T <u>IN</u> R <u>4W</u>	<u>B-5</u>
	T _____ R _____	_____
	T _____ R _____	_____
	T _____ R _____	_____
2. Property Controlling in Section	S _____ T _____ R _____	_____
	S _____ T _____ R _____	_____
3. Miscellaneous Property in Sec.	S _____ T _____ R _____	_____
	S _____ T _____ R _____	_____

93 OCT -7 AM 9:10

LINDA M. TWITCHELL  
REGISTER OF DEEDS  
EATON COUNTY, MICH.

Register of Deeds Stamp & File Number

4. Lot No. \_\_\_\_\_, Recorded Plat \_\_\_\_\_  
5. Private Claims \_\_\_\_\_

A	B	C	D	E	F	G	H	I	J	K	L	I
2	6	5	4	3	2	1						
3												
4	7	8	9	10	11	12						
5	13	14	15	16	17	18						
6	18	17	16	15	14	13						
7												
8	19	20	21	22	23	24						
9												
10	30	29	28	27	26	25						
11												
12	31	32	33	34	35	36						
13												

I, David R. Lohr, in a field survey on July 31, 19 93, do hereby certify that under requirements of P.A. 74, Michigan P.A. of 1970, the corner points mentioned in lines 1 and 2 above were in conformance with regulations and rules therefore as required in the current manual of survey instructions of the United States Department of the Interior, Bureau of Land Management or by a decree of a Court of Law and/or that the corner points mentioned in lines 3, 4 and 5 above were in conformance with the rules of the Michigan Board of Land Surveyors or by a Decree of a Court of Law; established, re-established, monumented, re-monumented, recovered, found as expressed below:

NOTE: Not more than 4 corners, all in the same town and range, may be recorded on this certificate.

A. Description of original monument and accessories and/or subsequent restoration:

- 3-5 Post set by Sylvester Sibley in 1825. Witnessed by Beech 6" N68°E, 17 links; Beech 8" S24°W, 12 links. No other references found in County Surveyors Records.  
3. Corner re-set by proportional measurement from Government dimensions in original survey by William Byl, May 10; 1982 as per Liber 2, Page 810, witnessed by set 1/2" re-rod in centerline of gravel road to East and West. Wm. Byl is RLS # 23502.

(OVER)

B. Description of corner evidence found and/or method applied in restoring or reestablishing corner:

- 3-5 Found 18" x 1/2" iron as per witnesses Liber 2, Page 810. Excavated 8' x 6' area thru 12" road gravel down to original ground (clay) dug 24" into clay and found nothing. Therefore, this corner is accepted as a careful and faithful re-establishment of the position of the original corner.


C. Description of monument for corner and accessories established to perpetuate locating the position of the corner:

- 3-5 Replaced 18" x 1/2" iron with 3/4" x 24" pin and cap #30090.  
Witnessed by: Set nail and tag #30090, S/S of Twin 16" Apple  
Northeast Corner of barn Az. 88° 530.39'  
Northwest corner of red barn Az. 221° 354.34'  
Top/CL telephone box Az. 70° 436.49'  
Az. 75° 84.00'

Signed by David R. Lohr

Date August 6, 1993

Surveyor's Michigan License No. 30090

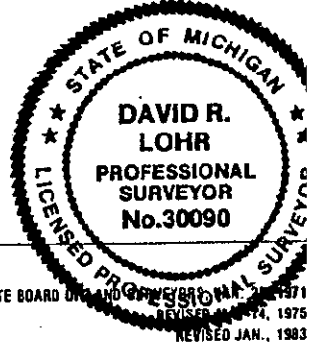

10/18/93

## A. (Continued)

B-5 North 1/4 Corner Section 18, T1N, R4W

1/2" re-rod with cap witnessed by:

Nail W/S of 36" stump	S	28.40'	
Nail S/S of 24" stump	WSW	83.17'	
C/L top MBT pedestal	ENE	83.85'	(Fd.- measured 84.00')
SE cor. Sec. 7 (Govt. Meas. 2640.00')	E	2644.95'	
SW cor. Sec. 7 (Govt. Meas. 2620.20')	W	2625.11'	

4. Private Surveyor's records reveal no additional data.