

SURVEY & REMONUMENTATION

APR 27 1995

COMMISSION

LAND CORNER RECORDATION CERTIFICATE
 Filing Requirement of Act 74, Mich. P.A. 1970

FILED
 copy

94 NOV -3 AM 11: 22

For corners in

<u>EATON COUNTY</u> (County)	Located In:	Corner Code #/
<u>BROOKFIELD TOWNSHIP</u>	T <u>1N</u> R <u>4W</u>	<u>B-6</u>
1. Public Land Survey	T _____ R _____	_____
	T _____ R _____	_____
	T _____ R _____	_____
	T _____ R _____	_____
2. Property Controlling in Section	S _____ T _____ R _____	_____
	S _____ T _____ R _____	_____
3. Miscellaneous Property In Sec.	S _____ T _____ R _____	_____
	S _____ T _____ R _____	_____

LINDA M. TWITCHELL
 REGISTER OF DEEDS
 EATON COUNTY, MICH.

LIBER 3 PG 177
 Register of Deeds Stamp & File Number

4. Lot No. _____, Recorded Plat _____
 5. Private Claims _____

	A	B	C	D	E	F	G	H	I	J	K	L	M
2	6		5		4		3		2		1		
3													
4	7		8		9		10		11		12		
5													
6	18		17		16		15		14		13		
7													
8	19		20		21		22		23		24		
9													
10	30		29		28		27		26		25		
11													
12	31		32		33		34		35		36		
13													

I, DAVID R. LOHR, in a field survey on OCTOBER 4, 19 94, do hereby certify that under requirements of P.A. 74, Michigan P.A. of 1970, the corner points mentioned in lines 1 and 2 above were in conformance with regulations and rules therefore as required in the current manual of survey instructions of the United States Department of the Interior, Bureau of Land Management or by a decree of a Court of Law and/or that the corner points mentioned in lines 3, 4 and 5 above were in conformance with the rules of the Michigan Board of Land Surveyors or by a Decree of a Court of Law; established, re-established, monumented, re-monumented, recovered, found as expressed below:

NOTE: Not more than 4 corners, all in the same town and range, may be recorded on this certificate.

A. Description of original monument and accessories and/or subsequent restoration:


- B-6: 1. CORNER WAS NOT SET IN ORIGINAL SURVEY OF 1825.
 2. NO RECORD OF SUBSEQUENT SURVEY IN COUNTY SURVEYOR'S RECORDS.
 3. PRIVATE SURVEYOR'S RECORDS REVEAL NO ADDITIONAL DATA.

B. Description of corner evidence found and/or method applied in restoring or reestablishing corner:

B-6: FOUND REMAINS OF ANCIENT ANCHOR POST AT INTERSECTION OF FENCE LINES. HAND EXCAVATED AREA 2' X 2' X 12" DEEP AROUND ANCIENT ANCHOR POST LOCATION. FOUND LARGE STONE (8" X 18") IN UPRIGHT POSITION ALONG WEST SIDE OF ANCHOR POST REMAINS. CANNOT FIND ANY EVIDENCE THAT THIS CORNER WAS EVER SET BY COUNTY SURVEYOR. TRAVERSED SECTION AND SET NEW CORNER AT INTERSECTION OF 1/4 LINES. CORNER FALLS 1.23' NORTH X 8.74' WEST OF FENCE CORNER REMAINS. SET 3/4" X 24" STANDARD REMON. BAR IN PILE OF STONES.
 DISTANCE NORTH 2642.76 FT. DISTANCE SOUTH 2647.40 FT.
 DISTANCE WEST 2627.05 FT. DISTANCE EAST 2643.81 FT.

C. Description of monument for corner and accessories established to perpetuate locating the position of the corner:

B-6: SET STANDARD 3/4" X 24" REMON BAR WITH PA 345 CAP #30090 AT INTERSECTION OF 1/4 LINES. WITNESSED BY:
 SET N/T 30090 NW/S 12" ELM AZ. 190° 19.49'
 SET N/T 30090 S/S 8" HICK. AZ. 107° 32.15'
 SET N/T 30090 NW/S 6" MAPLE AZ. 82° 22.32'
 SET N/T 30090 SE/S 12" MAPLE AZ. 71° 16.65'
 SET N/T 30090 SW/S 6" MAPLE AZ. 42° 8.00'
 SET N/T 30090 NE/S TW. 12" ELM AZ. 311° 23.17'

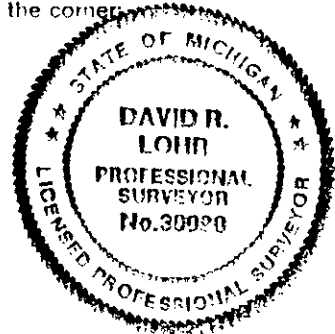

Signed by David R. Lohr

Date OCTOBER 25, 1994

Surveyor's Michigan License No. 30090