

**SURVEY & REMONUMENTATION**

OCT 16 1993

**COMMISSION**

**LAND CORNER RECORDATION CERTIFICATE**  
**Filing Requirement of Act 74, Mich. P.A. 1970**

*LIBER 3 PAGE 265*

For corners in:

<u>Eaton</u> (County)	Located In:	Corner Code #
<b>Brookfield Twp.</b>		
1. Public Land Survey	T <u>1N</u> R <u>4W</u>	<u>B-7</u>
	T _____ R _____	_____
	T _____ R _____	_____
	T _____ R _____	_____
2. Property Controlling in Section	S _____ T _____ R _____	_____
	S _____ T _____ R _____	_____
3. Miscellaneous Property in Sec.	S _____ T _____ R _____	_____
	S _____ T _____ R _____	_____
4. Lot No. _____, Recorded Plat _____		
5. Private Claims _____		

**FILED**  
*Copy*  
 93 OCT -7 AM 9:10  
 LINDA M. TWIN  
 REGISTER OF DEEDS  
 EATON COUNTY, MICH.

	A	B	C	D	E	F	G	H	I	J	K	L	M
2	6		5		4		3		2		1		
3													
4	7		8		9		10		11		12		
5													
6	18		17		16		15		14		13		
7	⊙												
8	19		20		21		22		23		24		
9													
10	30		29		28		27		26		25		
11													
12	31		32		33		34		35		36		
13													

I, **David R. Lohr**, in a field survey on July 31, 19 93, do hereby certify that under requirements of P.A. 74, Michigan P.A. of 1970, the corner points mentioned in lines 1 and 2 above were in conformance with regulations and rules therefore as required in the current manual of survey instructions of the United States Department of the Interior, Bureau of Land Management or by a decree of a Court of Law and/or that the corner points mentioned in lines 3, 4 and 5 above were in conformance with the rules of the Michigan Board of Land Surveyors or by a Decree of a Court of Law; established, re-established, monumented, re-monumented, recovered, found as expressed below:

**NOTE: Not more than 4 corners, all in the same town and range, may be recorded on this certificate.**

**A. Description of original monument and accessories and/or subsequent restoration:**

- B-7: 1. Post set by Sylvester Sibley in 1825. Witnessed by 24" Pepperage, S10 1/2°E, 11 lks., Beech 8"N46°E, 20 lks. 2. Marginal note on Pg. 163, Road Commission copy of GLO notes. Corner fd. By Harvey A. Williams, 1917. "Fd. stone," witnessed by: 12" apple, S56.5°E, 33.0' 14" Maple, N12°E, 30.5' 4" Cherry, S'1/2° E, 24 1/2'
- 3. No subsequent record of other surveys in COUNTY Surveyors Records.
- 4. No Act 74 certificate recorded for this corner.
- 5. Private surveyors records reveal no additional data.


**B. Description of corner evidence found and/or method applied in restoring or reestablishing corner:**

- B-7: Found boat spike leaning to east over top of pointed stone, excavated to find remains of 30" long original wood post under stone. This corner is accepted as a careful and faithful perpetuation of the position of the original corner.

**C. Description of monument for corner and accessories established to perpetuate locating the position of the corner:**

- B-7: Removed remains of wood post and reset top of pointed stone 16" deep. Set 3/4" x 24" remon iron along side of point stone. (West side)  
 Witnessed by: Set N&T #30090 SW/S 16" Popular Az. 298° 100.37'  
 Set N&T #30090 SE/S 18" Maple Az. 79° 119.28'  
 Angle iron post Az. 180° 67.24'  
 Set N&T #30090 SE/S 36" Maple Az. 72° 73.17'  
 Set N&T #30090 SE/S 34" Maple Az. 14° 30.93'

Signed by David R. Lohr Date August 6, 1993  
 Surveyor's Michigan License No. 30090

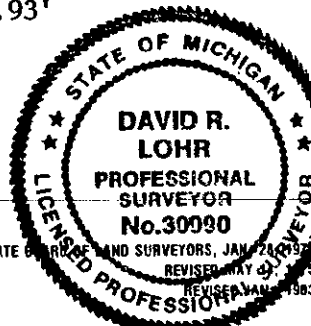

P.A. 345 EATON COUNTY  
 PEER APPROVED 8/25/93 ml

*10/18/93*