

OCT 16 1993

COMMISSION

LAND CORNER RECORDATION CERTIFICATE  
Filing Requirement of Act 74, Mich. P.A. 1970

LIBER 3 PAGE 270

FILED

copy

93 OCT -7 AM 9: 11

LINDA M. TWITCHELL  
REGISTER OF DEEDS  
EATON COUNTY, MICH.

Register of Deeds Stamp & File Number

For corners in

<u>EATON COUNTY</u> (County)	Located In:	Corner Code ##
1. Brookfield Township Public Land Survey	T <u>1N</u> R <u>4W</u>	<u>C-6</u>
	T _____ R _____	_____
	T _____ R _____	_____
	T _____ R _____	_____
2. Property Controlling in Section	S _____ T _____ R _____	_____
	S _____ T _____ R _____	_____
3. Miscellaneous Property in Sec.	S _____ T _____ R _____	_____
	S _____ T _____ R _____	_____

- 4. Lot No. \_\_\_\_\_, Recorded Plat \_\_\_\_\_
- 5. Private Claims \_\_\_\_\_

I, David R. Lohr, in a field survey on May 26, 19 93, do hereby certify that under requirements of P.A. 74, Michigan P.A. of 1970, the corner points mentioned in lines 1 and 2 above were in conformance with regulations and rules therefore as required in the current manual of survey instructions of the United States Department of the Interior, Bureau of Land Management or by a decree of a Court of Law and/or that the corner points mentioned in lines 3, 4 and 5 above were in conformance with the rules of the Michigan Board of Land Surveyors or by a Decree of a Court of Law; established, re-established, monumented, re-monumented, recovered, found as expressed below:

**NOTE: Not more than 4 corners, all in the same town and range, may be recorded on this certificate.**

A. Description of original monument and accessories and/or subsequent restoration:

- 1. C-6 Post set by Sylvester Sibley in 1825. Witnessed by Yellow Oak 7" S18°E 28 links; Tamarack 5" N70°W 16 links.
- 2. No record of subsequent surveys in County Surveyor Records
- 3. Corner re-established by single proportionate measure by Robert Reed on May 9, 1980 recorded in Liber 2, page 665. (LCRC-Act 74)

RLS#19004


(OVER)

B. Description of corner evidence found and/or method applied in restoring or reestablishing corner:

C-6 Found 1/2" iron on fence line to East. Iron was set by R. Reed using acceptable method in 19  
No excavation was performed due to excessive road fill (about 6 feet)  
1/2" iron is accepted as corner monument.  
Location of iron found is substantiated by existing 24" stump found 49.5' East.  
  
This corner is accepted as a careful and faithful reestablishment of the position of the original corner.

C. Description of monument for corner and accessories established to perpetuate locating the position of the corner:

- C-6 Left 1/2" iron in place with following witnesses.
- Set nail and tag #30090, W/S 15" ELM Az. 34° 22.08'
- Set nail and tag #30090, S/S of 5" Cherry Az. 75° 34.58'
- Set nail and tag #30090, SW/S of 14" Elm Az. 128° 53.63'
- Set nail and tag #30090, SE/S of 12" Walnut Az. 225° 46.41'
- Set nail and tag #30090, NE/S of 12" Walnut Az. 330° 53.29'

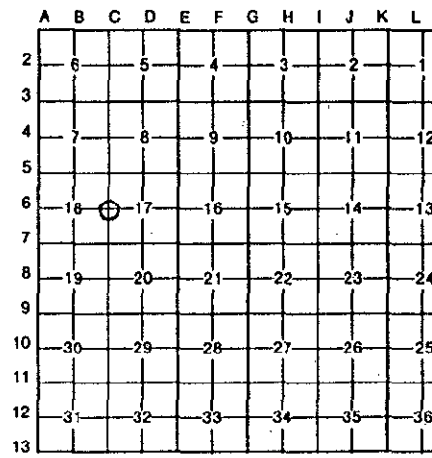

Signed by David R. Lohr Date August 9, 1993  
Surveyor's Michigan License No. 30090

FORM APPROVED BY MICHIGAN STATE

P.A. 345 EATON COUNTY  
PEER APPROVED 9/15/93



10/18/93

A. (Continued)

C-6: 3. "Set 1/2" iron bar with RLS cap."

Witnessed by:

18" maple	East	49.5'	P.K. nail, North side tree.
10" walnut	WSW	38'	P.K. nail, North side tree.
6" twin elm	SSE	55.6'	P.K. nail, West side tree.

4. CORNER REFERENCED IN SURVEYS BY ROBERT REED, LS #19004, ON FOLLOWING:

MAY 13, 1980 RECORDED IN LIBER 3, PAGE 149  
NOVEMBER 30, 1983 RECORDED IN LIBER 3, PAGE 625  
FEBRUARY 1, 1978 RECORDED IN LIBER 2, PAGE 522

REED HAS REPORTED THAT HE MEASURED NORTH TO C-5 A DISTANCE OF 2644.65' AND SOUTH TO C-7 A DISTANCE OF 2644.65'

5. SURVEYOR'S RECORDS REVEAL NO ADDITIONAL DATA.