

SURVEY &
REMONUMENTATION

OCT 16 1993

COMMISSION

LAND CORNER RECORDATION CERTIFICATE
Filing Requirement of Act 74, Mich. P.A. 1970

LIBER 3 PAGE

274

For corners in

<u>EATON</u> (County)	Located In:	Corner Code #
Brookfield Township		
1. Public Land Survey	T <u>1N</u> R <u>4W</u>	<u>C-8</u>
	T _____ R _____	_____
	T _____ R _____	_____
	T _____ R _____	_____
2. Property Controlling in Section	S _____ T _____ R _____	_____
	S _____ T _____ R _____	_____
3. Miscellaneous Property in Sec.	S _____ T _____ R _____	_____
	S _____ T _____ R _____	_____

FILED
copy

93 OCT -7 AM 9: 11

LINDA M. TWITCHELL
REGISTER OF DEEDS
EATON COUNTY, MICH.

Register of Deeds Stamp & File Number

4. Lot No. _____, Recorded Plat _____
5. Private Claims _____

A	B	C	D	E	F	G	H	I	J	K	L
2	6	5	4	3	2	1					
3											
4	7	8	9	10	11	12					
5											
6	18	17	16	15	14	13					
7											
8	19	20	21	22	23	24					
9											
10	30	29	28	27	26	25					
11											
12	31	32	33	34	35	36					
13											

I, DAVID R. LOHR, in a field survey on MAY 26, 19 93, do hereby certify that under requirements of P.A. 74, Michigan P.A. of 1970, the corner points mentioned in lines 1 and 2 above were in conformance with regulations and rules therefore as required in the current manual of survey instructions of the United States Department of the Interior, Bureau of Land Management or by a decree of a Court of Law and/or that the corner points mentioned in lines 3, 4 and 5 above were in conformance with the rules of the Michigan Board of Land Surveyors or by a Decree of a Court of Law; established, re-established, monumented, re-monumented, recovered, found as expressed below:

NOTE: Not more than 4 corners, all in the same town and range, may be recorded on this certificate.

A. Description of original monument and accessories and/or subsequent restoration:

- C-8 1. Post set by Sylvester Sibley in 1825. Witnessed by Beech 8" S 19° E, 6 links, Beech 10" N48°W, 28 links.
- 2. Survey recorded in Vol. 2- Pg. 32, by Church, Co Surveyor, dated June 1876, shows "Stone, FOS" (Found Original Stake) No witnesses given.
- 3. Corner Re-set by Larry Bryan on April 8, 1983 recorded in Liber 2 page 946.

"1/2" Iron and cap set midway on Line between NW corner, Section 20 and SW corner, Section 20, corner falls on fence Line to West."

(OVER)

B. Description of corner evidence found and/or method applied in restoring or reestablishing corner:

C-8 Found 1/2" Iron as per Liber 2 Page 946.

Excavated area 9' X 6' found large stone in proximity of 1/2" Iron at depth of 27" below surface at original ground. Excavated to 48" found nothing more. While backfilling hole found 1 quart pottery bottle, presumed to be set with large stone. Accepted 1/2" Iron near large stone as a careful and faithful re-establishment of the position of the original corner.

C. Description of monument for corner and accessories established to perpetuate locating the position of the corner:

- C-8 replaced 1/2" Iron with 3/4" X 24" Remon Pin with following witnesses:
- Set nail and tag #30090 W/S 18" tree Az. 09° 143.04'
- Set nail and tag #30090 S/S power pole Az. 95° 28.62'
- set nail and tag #30090 NW/S 14" Oak Az. 155° 29.91'
- set nail and tag #30090 W/S post Az. 266° 23.27'
- Set nail and Tag #30090 N/S Twin 14" Tree Az. 298° 24.02'


Signed by David R. Lohr Date August 9, 1993

Surveyor's Michigan License No. 30090

P.A. 345 EATON COUNTY

PEER APPROVED 8/25/93 m

FORM APPROVED BY MICHIGAN STATE BOARD OF LAND SURVEYORS, JAN. 2, 1988, REVISED MAY 1991

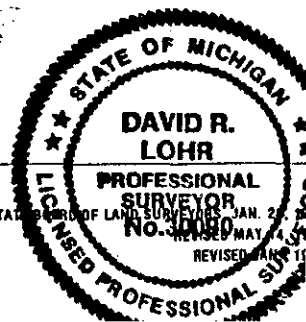

10/18/93

A. (continued)

Witnessed by:

- C-8: 3.P.K. nail South side corner post, West 23.27' (Fd. post-measured 23.27')
- P.K. nail West side 8" Oak, S25°E, 29.91' (Fd. 14" Oak-measured 29.91')
- P.K. nail East side Twin 6" Oak, S20°W, 38.03'
- (Meas. 2649.35' North and South.

4. CORNER USED IN TRAVERSE FOR SURVEY BY LARRY BRYAN, DATED APRIL 8, 1983, RECORDED IN LIBER 3, PAGE 576. TRAVERSE COMP. SHEET SHOWS DISTANCE TO C-7 AS 2649.35' AND DISTANCE TO C-9 AS 2649.35'.

5. SURVEYOR'S RECORDS REVEAL NO ADDITIONAL DATA.