

LAND CORNER RECORDATION CERTIFICATE
Filing Requirement of Act 74, Mich. P.A. 1970

LIBER 3 PAGE 276

FILED

copy

93 OCT -7 AM 9:13

LINDA M. TWITCHELL
 Registrar of Deeds
 EATON COUNTY, MICH.

For corners in EATON
 (County)

Located In: BROOKFIELD TOWNSHIP Corner Code # C-9

1. Public Land Survey T IN R AW C-9

2. Properly Controlling In Section S T R

3. Miscellaneous Properly In Sec. S T R

4. Lot No. _____, Recorded Plat _____

5. Private Claims _____

	A	B	C	D	E	F	G	H	I	J	K	L	M
2													
3													
I, DAVID R. LOHR, in a field survey on MAY 26, 1993, do hereby certify that under requirements of P.A. 74, Michigan P.A. of 1970, the corner points mentioned in lines 1 and 2 above were in conformance with regulations and rules theretofore as required in the current manual of survey instructions of the United States Department of the Interior, Bureau of Land Management or by a decree of a Court of Law and/or that the corner points mentioned in lines 3, 4 and 5 above were in conformance with the rules of the Michigan Board of Land Surveyors or by a Decree of a Court of Law; established, re-established, monumented, re-monumented, recovered, found as expressed below:

NOTE: Not more than 4 corners, all in the same town and range, may be recorded on this certificate.


- A. Description of original monument and accessories and/or subsequent restoration:
- 1. POST SET BY SYLVESTER SIBLEY IN 1825, WITNESSED BY 8" BEECH, SOUTH 40° EAST, 21 LINKS, 22" BEECH NORTH 7° WEST, 24 LINKS
 - 2. MARGINAL NOTE ON ROAD COMMISSION COPY OF ORIGINAL GLO NOTES ON PAGE 162 BY UNKNOWN SURVEYOR. SHOWS "STONE AND CROCKERY" WITNESSED BY:
 SOUTHEAST CORNER SCHOOL NORTHWEST 83.7'
 NORTHEAST CORNER SCHOOL NORTHWEST 104.3' DATED MAY 4, 1922
 SOUTHWEST CORNER SCHOOL NORTHWEST 106.8'

- B. Description of corner evidence found and/or method applied in restoring or reestablishing corner:
- COMMON WITNESSES TO SCHOOL BUILDING IN NORTHWEST DIRECTION ARE COMMON ON 1922 MARGINAL NOTES AND 1958 ROAD COMMISSION CONSTRUCTION PLANS. HAND EXCAVATED INTERIOR OF MONUMENT BOX AND FOUND 1" STEEL BAR AT DEPTH OF 19" BELOW 3/4" PIPE. AT DEPTH OF 30" FOUND LARGE STONE. THIS STONE IS BELIEVED TO BE THE SAME STONE AS NOTED IN 1876. (ITEM #3, PART A.) THE 3/4" PIPE IS ACCEPTED BASED ON 1958 WITNESSES TO SCHOOL AND IDENTIFICATION AS A 3/4" PIPE. ITS LOCATION IS SUPPORTED BY LOCATION OF STONE 30" DEEP. 1988 DISTANCE SHOWN ON SURVEY 860-L (ITEM 8-PART A) OF 2648.09' MATCHES STATIONING SHOWN ON 1958 PLANS. STATIONING DISTANCE IS SHOWN TO BE 2648.18'.
 - FOUND 3/4" PIPE IN MONUMENT BOX.
 - 3/4" PIPE IN ACCEPTED AS THE BEST AVAILABLE EVIDENCE OF THE POSITION OF THE ORIGINAL CORNER

- C. Description of monument for corner and accessories established to perpetuate locating the position of the corner:
- ACCEPTED LOCATION OF 3/4" PIPE, REMOVED PIPE AND SET 3/4" PIN IN MONUMENT BOX (3/4" X 24" REMON PIN WITH CAP) WITH FOLLOWING WITNESSES:
 SET NAIL AND TAG #30090 IN WEST SIDE ON 18" ELM Az. 07°, 156.92'
 SET NAIL AND TAG #30090 IN WEST SIDE OF 12" ELM Az. 169°, 130.00'
 SET NAIL AND TAG #30090 IN EAST SIDE OF 10" ELM Az. 189°, 102.42'
 FOUND P.K. NAIL IN EAST SIDE OF 24" MAPLE Az. 347°, 129.94'

Signed by David R. Lohr
 Surveyor's Michigan License No. 30090

Date AUGUST 9, 1993

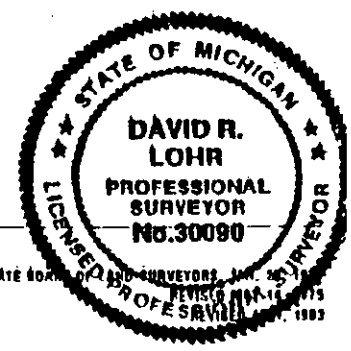

P.A. 345 EATON COUNTY
 PEER APPROVED 8/25/93

PART A CONTINUED

C-9

- 3. SURVEY RECORDED IN VOLUME 2, PAGE 32, BY CHURCH, COUNTY SURVEYOR, DATED JUNE 1876, SHOWS "STONE, SET BY SEARLES. NO WITNESSES GIVEN.
- 4. EATON COUNTY ROAD COMMISSION FIELD NOTES, DATED JANUARY 14, 1922, SHOW "STONE AND CROCKERY". WITNESSED BY:
 SOUTHEAST CORNER SCHOOL HOUSE NORTHWEST 83.7'
 NORTHEAST CORNER SCHOOLHOUSE NORTHWEST 104.3'
 SOUTHWEST CORNER SCHOOLHOUSE NORTHWEST 106.8'
- 5. EATON COUNTY ROAD COMMISSION CONSTRUCTION PLANS, DATED 1958, SHOW "APP. SECTION CORNER" TO BE P.I. #14, STATION 270 + 15.55, WITNESSED BY:
 SCHOOL NORTHWEST 83.70'
 CORNER POST SOUTHEAST 49.10'
 T.P. ESE 95.93'
 STATIONING SHOWS DISTANCE WEST TO B-9 AS 2648.18
 PLANS CALL FOR POINT BEING 3/4" IRON
- 6. CORNER FOUND BY LARRY BRYAN, RLS #25832, ON APRIL 8, 1983, AS RECORDED IN LIBER 2, PAGE 945.
 "1/2" IRON FOUND IN CENTERLINE BELLEVUE AND SHERMAN ROADS WITNESSED BY:"
 P.K. NAIL WEST SIDE OF 5" ELM, SOUTH 15° EAST, 129.83' (FOUND 12" ELM, MEASURED 130.00')
 P.K. NAIL WEST SIDE OF 6" ELM, NORTH 10° EAST, 115.82'
 P.K. NAIL EAST SIDE OS 24" MAPLE, NORTH 30° WEST, 129.94' (FOUND P.K. NAIL, MEASURED 129.94')
- 7. CORNER USED IN TRAVERSE FOR SURVEY BY LARRY BRYAN, DATED APRIL 8, 1983, AS RECORDED IN LIBER 3, PAGE 576. TRAVERSE COMP SHEET SHOWS DISTANCE TO C-8 AS 2649.35' AND DISTANCE TO C-7 AS 5298.70'
- 8. CORNER REFERRED TO BY DOUGLAS RICHARDSON, LS #31603, ON AUGUST 16, 1988, IN UNRECORDED SURVEY #860-L. SURVEY SHOWS DISTANCE OF 2648.09' TO B-9, NO WITNESSES SHOWN.
- 9. SURVEYOR'S RECORDS REVEAL NO ADDITIONAL DATA