

SURVEY & REMONUMENTATION

FILED

DEC 09 1999

99 JUL -8 AM 11:42

SECTION

LAND CORNER RECORDATION CERTIFICATE
Filing Requirement of Act 74, Mich. P.A. 1970

For corners in

LINDA M. TWITCHELL
REGISTER OF DEEDS
EATON COUNTY, MICH.

<u>EATON</u>	Located In:	Corner Code #
(County)	BROOKFIELD TOWNSHIP	
1. Public Land Survey	T <u>1N</u> R <u>4W</u>	<u>K-7</u>
	T _____ R _____	_____
	T _____ R _____	_____
	T _____ R _____	_____
2. Property Controlling in Section	S _____ T _____ R _____	_____
	S _____ T _____ R _____	_____
3. Miscellaneous Property in Sec.	S _____ T _____ R _____	_____
	S _____ T _____ R _____	_____

LIBER 4 PAGE 26

Register of Deeds Stamp & File Number

4. Lot No. _____, Recorded Plat _____
5. Private Claims _____

I, RON HELSEL, in a field survey on MAY 5, 1999 do hereby certify that under requirements of P.A. 74, Michigan P.A. of 1970, the corner points mentioned in lines 1 and 2 above were in conformance with regulations and rules therefore as required in the current manual of survey instructions of the United States Department of the Interior, Bureau of Land Management or by a decree of a Court of Law and /or that the corner points mentioned in lines 3, 4 and 5 above were in conformance with the rules of the Michigan Board of Land Surveyors or by a Decree of a Court of Law; established, re-established, monumented, re-monumented, recovered, found as expressed below:

A	B	C	D	E	F	G	H	I	J	K	L	M
1												
2	6		5		4		3		2		1	
3												
4	7		8		9		10		11		12	
5												
6	18		17		16		15		14		13	
7												
8	19		20		21		22		23		24	
9												
10	30		29		28		27		26		25	
11												
12	31		32		33		34		35		36	
13												


NOTE: Not more than 4 corners, all in the same town and range, may be recorded on this certificate.

A. Description of original monument and accessories and/or subsequent restoration:
ORIGINAL MONUMENT: POST SET BY SYLVESTER SIBLEY, U.S. DEPUTY SURVEYOR IN 1825. W. OAK 40, N27W, 29 LINKS
BOXWOOD 6, S63E, 31 LINKS

- VOL. 2, PAGES 118-119, DATED FEB. 11-13, 1880, COUNTY SURVEYOR M.H. BAILEY CALLED FOR STAKE AND STONE AT THIS CORNER. NO WITNESSES.
- L.C.R.C. LIBER 3, PAGE 71, DATED SEPT. 19, 1988 ALONG WITH A P.A. 132 SURVEY RECORDED IN LIBER, PAGE 586 OF SURVEYS OF SAME DATE, RECORDED BY M. MAHIEU, P.S. 28414. "FOUND 1/2" IRON ROD AND CAP #3276 AT INTERSECTION OF THUMA ROAD AND HOLMES HIGHWAY. LEFT 1/2" IRON ROD IN PLACE, WITNESSED BY:
NAIL AND TAG ON NORTH SIDE OF 18" WILLOW, S60°E 69.85 FEET (TREE GONE)
NAIL AND TAG ON NORTH SIDE OF UTILITY POLE, S50°E 47.18 FEET (FOUND G. YOUNG TAG #17640)
NAIL AND TAG ON WEST SIDE OF 38" MAPLE, S20°E 74.54 FEET (FOUND L. BRYAN TAG #25832)
NAIL AND TAG ON SOUTH SIDE OF UTILITY POLE, WEST 52.30 FEET (FOUND TAG #17640)

B. Description of corner evidence found and/or method applied in restoring or reestablishing corner:
FOUND A 1/2" REBAR WITH UNREADABLE CAP AT THE CENTERLINES OF HOLMES HWY. AND THUMA ROAD, ON LINE WITH FIELD SEPARATION LINE TO THE WEST. EXCAVATED A 6' BY 6' HOLE DOWN ABOUT TWO FEET AND WELL BELOW THE GRAVEL AND SAND TO THE CLAY ROAD BED. FOUND AN 18" LONG BY 1/4" 1" HORIZONTAL FLAT IRON BAR UNDER THE 1/2" REBAR. DID NOT FIND ANY EVIDENCE OF A PREVIOUS CORNER. MEASURED EAST 2635.59 FEET TO L-7 (SOUTH 1/4 CORNER) AND NORTH 5279.65 FEET TO THE NORTHWEST CORNER (K-5). ACCEPTED THE POSITION OF THE 1/2" REBAR AS FAITHFUL PERPETUATION OF THE CORNER AND SET A STANDARD EATON COUNTY 2" DISK ON THE 1/2" BAR STAMPED P.A. 345, P.S. NO. 18994.

C. Description of monument for corner and accessories established to perpetuate locating the position of the corner:
BAR AND STANDARD EATON COUNTY 2" DISK AT INTERSECTION OF THE ROAD CENTERLINES.
FOUND NAIL AND TAG NO. 17640, SOUTH/SIDE OF POWER POLE, AZ. 250°, 52.30 FEET
FOUND NAIL AND TAG NO. 25832, WEST/SIDE 38" MAPLE, AZ. 168°, 74.88 FEET
SOUTH WEST CORNER CONC. PORCH OF STONE FOUNDATION HOUSE, AZ. 148°, 83.98 FEET
FOUND NAIL AND TAG NO. 17640, NORTH/SIDE UTILITY POLE, 47.19 FEET
SET NAIL AND TAG NO. 18994, NORTH/SIDE 26" MAPLE, 118.60 FEET

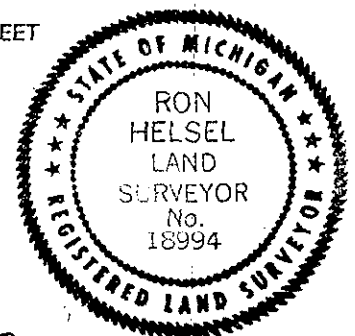

Signed by Ron Helsel
Surveyor's Michigan License No. 18994

Date 6-24-99

P.A. 345 EATON COUNTY
PEER APPROVED 6/15/99