

**SURVEY &
REMONUMENTATION**

APR 27 1995

COMMISSION

LAND CORNER RECONSTRUCTION CERTIFICATE
Filing Requirement of Act 74, Mich. P.A. 1970

FILED
Copy
94 NOV -3 AM 11:23

For corners in

<u>EATON COUNTY</u> <small>(County)</small>	Located In:	Corner Code #
<u>WALTON TOWNSHIP</u>		
1. Public Land Survey	T <u>1N</u> R <u>5W</u>	<u>I-6</u>
	T _____ R _____	_____
	T _____ R _____	_____
	T _____ R _____	_____
2. Property Controlling in Section	S _____ T _____ R _____	_____
	S _____ T _____ R _____	_____
3. Miscellaneous Property in Sec.	S _____ T _____ R _____	_____
	S _____ T _____ R _____	_____
4. Lot No. _____, Recorded Plat _____		
5. Private Claims _____		

LINDA M. TWITCHELL
REGISTER OF DEEDS
EATON COUNTY, MICH.

LIBER 3 PG 481

Register of Deeds Stamp & File Number

	A	B	C	D	E	F	G	H	I	J	K	L	M
2	6	5	4	3	2	1							
3													
4	7	8	9	10	11	12							
5													
6	18	17	16	15	14	13							
7													
8	19	20	21	22	23	24							
9													
10	30	29	28	27	26	25							
11													
12	31	32	33	34	35	36							
13													

I, DAVID R. LOHR, in a field survey on OCT. 15, 19 94, do hereby certify that under requirements of P.A. 74, Michigan P.A. of 1970, the corner points mentioned in lines 1 and 2 above were in conformance with regulations and rules therefore as required in the current manual of survey instructions of the United States Department of the Interior, Bureau of Land Management or by a decree of a Court of Law and/or that the corner points mentioned in lines 3, 4 and 5 above were in conformance with the rules of the Michigan Board of Land Surveyors or by a Decree of a Court of Law; established, re-established, monumented, re-monumented, recovered, found as expressed below:

NOTE: Not more than 4 corners, all in the same town and range, may be recorded on this certificate.

A. Description of original monument and accessories and/or subsequent restoration:

- I-6: 1. POST SET BY SYLVESTER SIBLEY, U.S. DEP. SURVEYOR IN 1825.
WITNESSED BY: BEECH 7" S 22 1/2 E 31 1ks (20.46')
ELM 24" N 63 W 23 1ks (15.18')
2. NO REFERENCES FOUND IN COUNTY SURVEYORS RECORDS.


CONTINUED ON BACK

B. Description of corner evidence found and/or method applied in restoring or reestablishing corner:

- I-6: FOUND 1/2" IRON, 5" DEEP IN GRAVEL RD. ON LINE OF FENCE TO SOUTH AND ALSO FOUND 5/8" PIPE 33.0' TO SOUTH. ACCEPTED 1/2" IRON AS PERPETUATED CORNER BASED ON TESTIMONY OF SURVEYOR HEISEL IN ITEM HA-4. SET 3/4" STANDARD REMON. BAR IN LOCATION OF 1/2" IRON, 3 FEET NORTH OF C/L OSBORN ROAD, ON LINE OF FENCE TO SOUTH.

C. Description of monument for corner and accessories established to perpetuate locating the position of the corner:

- I-6: 3/4" X 24" STANDARD REMON. BAR/PA 345 CAP H30090,
3' NORTH C/L OSBORN ROAD ON LINE OF FENCE TO SOUTH.
SET N&T 30090 E/S POST AZ. 158° 18.30'
NORTH EDGE ANGLE IRON POST AZ. 180° 24.65'
SET N&T 30090 E/S 7" BL. WAL. AZ. 182° 50.83'
SET N&T 30090 N/S P. POLE AZ. 251° 73.90'

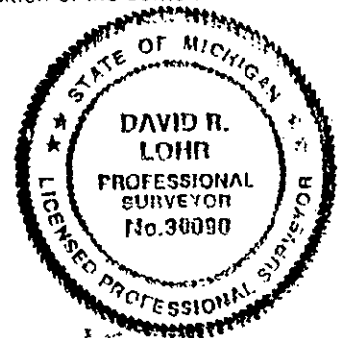

Signed by David R. Lohr

Date OCTOBER 25, 1994

Surveyor's Michigan License No. 30090

P.A. 345 EATON COUNTY
PEER APPROVED 10/20/94 M

1-8 PART A - CONTINUED

3. CORNER REFERENCED IN SURVEY BY RON HELSEL PS #18994, DATED 3/6/79
WHITE ENG. JOB #79-7463, RECORDED IN LIBER 2 PG. 901. "FOUND PLOW
PT. SET 1/2" IRON BAR AND CAP.

WITNESSED BY:

S 50° W	49.88 FT.	N&T SE/S 10" WALNUT
S 65° W	61.61 FT.	N&T SE/S 8" WALNUT
SOUTH	33.0 FT.	5/8" IRON PIPE

4. CORNER REFERENCED IN SURVEY BY RON HELSEL, PS #18994, DATED 3/8/79
AND RECORDED IN LIBER 2 PG. 901 "FOUND PLOW PT. ON PYRAMID OF ROCKS,
BROUGHT TO SURFACE WITH 1/2" IRON BAR AND CAP. CORNER ON LINE WITH
FENCE TO SOUTH AND 33.00 FT. NORTH OF AN OLD IRON."

WITNESSED BY:

S 50° W	49.88 FT.	N&T SE/S 10" WALNUT
S 65° W	61.61 FT.	N&T SE/S 8" WALNUT
SOUTH	33.0 FT.	5/8" IRON PIPE