

Surveyor's Registration

FILED

FEB 22 1996

LAND CORNER RECORDATION CERTIFICATE
Filing Requirement of Act 74, Mich. P.A. 1970

95 OCT 17 AM 9:27

For corners in WALTON TOWNSHIP
EATON COUNTY
(County)

Located In:

Corner Code #

LINDA M. TWITCHELL
REGISTER OF DEEDS
EATON COUNTY, MICH.

Copy

LIBER 3 Pg 618

Register of Deeds Stamp & File Number

- 1. Public Land Survey T 1N R 5W I-7
- T R
- T R
- T R
- 2. Property Controlling S T R
- in Section S T R
- 3. Miscellaneous S T R
- Property in Section S T R

- 4. Lot No. _____, Recorded Plat _____
- 5. Private Claims _____

I, DAVID R. LOHR, in a field survey on JUNE 12, 19 95, do hereby certify that under requirements of P.A. 74, Michigan P.A. of 1970, the corner points mentioned in lines 1 and 2 above were in conformance with regulations and rules therefore as required in the current manual of survey instructions of the United States Department of the Interior, Bureau of Land Management or by a decree of a Court of Law and/or that the corner points mentioned in lines 3, 4 and 5 above were in conformance with the rules of the Michigan Board of Professional Surveyors or by a Decree of a Court of Law; established, re-established, monumented, re-monumented, recovered, found as expressed below:

A	B	C	D	E	F	G	H	I	J	K	L	M
2	6	5	4	3	2	1						
3												
4	7	8	9	10	11	12						
5												
6	18	17	16	15	14	13						
7												
8	19	20	21	22	23	24						
9												
10	30	29	28	27	26	25						
11												
12	31	32	33	34	35	36						
13												

NOTE: Not more than 4 corners, all in the same town and range, may be recorded on this certificate.

A. Description of original monument and accessories and/or subsequent restoration:


- I-7: 1. POST SET BY SYLVESTER SIBLEY, U.S. DEP. SURVEYOR IN 1825.
WITNESSED BY: ELM 18" N 74° E 15 lks (9.90')
 W. ASH 18" N 60° W 18 lks (11.88')
- 2. NO REFERENCES FOUND IN COUNTY SURVEYORS RECORDS.
- 3. NO REFERENCES FOUND IN PRIVATE SURVEY RECORDS.

B. Description of corner evidence found and/or method applied in restoring or reestablishing corner:

I-7: SEARCHED AT APPARENT LOCATION OF CORNER AND FOUND REMAINS OF ANCIENT ANCHOR POST 1 FT. NORTH OF MODERN ANCHOR POST. POST REMAINS WERE LYING IN 4" OF STANDING WATER. FENCES RUNNING NORTH-SOUTH-EAST-WEST, TRAVERSED ENTIRE SECTION 14, MEASURED NORTH 2654.87 FT. TO I-6 AND 2683.19 EAST TO J-7. ACCEPTED LOCATION OF ANCIENT ANCHOR POST AND SET 3/4" X 24" STANDARD REMON. BAR/PA 345 CAP #30090 AT ITS BASE.

C. Description of monument for corner and accessories established to perpetuate locating the position of the corner:

- I-7: SET 3/4" X 24" STANDARD REMON. BAR/PA 345 CAP #30090, AT LOCATION OF BASE OF ANCIENT ANCHOR POST. WITNESSED BY:
SET N&T #30090 W/S TRI.12" BL. ASH AZ. 9° 37.69'
SET N&T #30090 W/S 18" BL. ASH AZ. 43° 43.20'
SET N&T #30090 S/S 30" OAK AZ. 85° 83.17'
SET N&T #30090 NW/S 12" BL.ASH AZ. 218° 14.52'

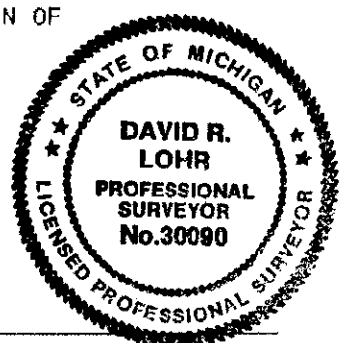

Signed by David R. Lohr

Date OCT 04 1995

Surveyor's Michigan License No. 30090

FORM APPROVED BY MICHIGAN STATE BOARD OF PROFESSIONAL SURVEYORS, JAN. 28, 1971
REVISED MAY 14, 1975
REVISED JAN., 1983

P.A. 345 EATON COUNTY
PEER APPROVED 9/28/95 ML