

DEC 16 1996

COMMISSION

FILED  
copy

96 OCT 30 PM 1:44

LAND CORNER RECORDATION CERTIFICATE  
Filing Requirement of Act 74, Mich. P.A. 1970

For corners in

<u>Eaton</u>	Located In:	Corner Code #
<u>Walton</u> (County) <u>Township</u>		
1. Public Land Survey	T <u>1N</u> R <u>5W</u>	<u>J-6</u>
	T ___ R ___	_____
	T ___ R ___	_____
	T ___ R ___	_____
2. Property Controlling in Section	S ___ T ___ R ___	_____
	S ___ T ___ R ___	_____
3. Miscellaneous Property in Sec.	S ___ T ___ R ___	_____
	S ___ T ___ R ___	_____

LINDA M. TWITCHELL  
REGISTER OF DEEDS  
EATON COUNTY, MICH.

Register of Deeds Stamp & File Number

4. Lot No. \_\_\_\_\_, Recorded Plat \_\_\_\_\_  
5. Private Claims \_\_\_\_\_

I, David R. Lohr, in a field survey on Sept 11, 1996 do hereby state that under requirements of P.A. 74, Michigan P.A. of 1970, the corner points mentioned in lines 1 and 2 above were in conformance with regulations and rules therefore as required in the current manual of survey instructions of the United States Department of the Interior, Bureau of Land Management or by a decree of a Court of Law and /or that the corner points mentioned in lines 3, 4 and 5 above were in conformance with the rules of the Michigan Board of Land Surveyors or by a Decree of a Court of Law; established, re-established, monumented, recovered, found as expressed below:

A	B	C	D	E	F	G	H	I	J	K	L
1											
2	6	5		4	3	2	1				
3											
4	7	8	9	10	11	12					
5											
6	18	17	16	15	14	13					
7											
8	19	20	21	22	23	24					
9											
10	30	29	28	27	26	25					
11											
12	31	32	33	34	35	36					
13											

NOTE: Not more than 2 corners, all in the same town and range, may be recorded on this certificate.

A. Description of original monument and accessories and/or subsequent restoration:


- J-6: 1. CORNER NOT SET IN ORIGINAL GOVERNMENT SURVEYS.  
 2. NO REFERENCE TO CORNER FOUND IN COUNTY SURVEYOR RECORDS.  
 3. CORNER REFERENCED IN UNRECORDED SURVEY BY K.D. FLUKE, L.S #18988, DATED 3/31/86, JOB #86-12, NO MENTION OF MONUMENT. (FOUND 1/2" IRON) WITNESSED BY: N46W, 35.67', ASH 27"-N24W, 73.11', BEECH 12" N28E, 68.28', BEECH 11"-S13E, 20.75', BOX ELD.6"  
 SURVEY SHOWS DISTANCE WEST TO I-6 OF 2633.97' AND DISTANCE NORTH TO J-5 OF 2660.48'. CORNER WAS SET 24' SOUTH OF ANCHOR POST REMAINS.  
 3. NO OTHER REFERENCES FOUND.

B. Description of corner evidence found and/or method applied in restoring or reestablishing corner:

- J-6: VISITED APPARENT LOCATION OF CORNER AND FOUND REMAINS OF ANCIENT WOOD ANCHOR POST WITH STONES AT INTERSECTION OF FENCES NORTH-EAST-WEST. FOUND 3 OF FLUKES WITNESSES OF 1986 (BOX ELDER TO SOUTHEAST IS GONE). FOUND 1/2" IRON (FLUKES) ABOUT 24' SOUTH OF ANCHOR POST REMAINS AS PER ITEM #3-PART "A". EXCAVATED A 2.5' X 2.5' HOLE AROUND FLUKE'S IRON, THRU 15" OF ROAD GRAVEL TO CLAY (ORIGINAL GROUND-NO TOPSOIL) AND FOUND NOTHING MORE. TRAVERSED SECTION 14 AND FOUND THIS IRON TO BE 9.92' SOUTH AND 6.91' WEST OF THE INTERSECTION OF THE 1/4 LINES. AS NO RECORD CAN CONTINUED ON BACK

C. Description of monument for corner and accessories established to perpetuate locating the position of the corner:

- J-6: SET 3/4" X 24" STANDARD REMON. BAR / PA#345 CAP #30090 AT INTERSECTION OF THE QUARTER LINES. WITNESSED BY:  
 FD. N/T #18988, NW/S 14" BEECH, AZ. 23-28-18, 56.21'  
 SET. N/T #30090, S/S 22" OAK, AZ. 81-25-30, 49.99'  
 FD. 1/2" IRON (FLUKE) AZ. 214-52-36, 12.09'  
 FD. N/T #18988, NE/S 27" ASH, AZ. 289-55-00, 36.50'  
 FD. N/T #18988, NE/S 12" BEECH, AZ. 322-21-06, 68.50'  
 TRAV. PT. #WL1-43-60 (1/2" IRON), AZ. 246-04-51, 70.94'  
 FD. 1 1/2" IRON/CAP #18988 (FLUKE) AZ. 343-03-11, 24.06'

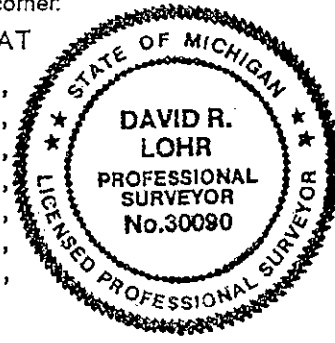

Signed by David R. Lohr  
Surveyor's Michigan License No. 30090

Date September 26, 1996

J-6: WALTON TOWNSHIP: PART B; CONTINUED

BE FOUND THAT THIS CORNER WAS EVER SET BY A COUNTY SURVEYOR, I SET 3/4" X 24" STANDARD REMON. BAR/PA #345 CAP #30090 AT THE INTERSECTION OF THE QUARTER LINES. CORNER FALLS 5 FT. NORTH OF NORTH EDGE OF GRAVEL IN OSBORN HIGHWAY, ABOUT 7 FT. EAST BY ABOUT 23 FT. SOUTH OF ANCHOR POST. STONES WERE PILED AROUND REMON. BAR AFTER IT WAS SET.

MEASURED 2650.85' NORTH TO J-5.	MEASURED 2659.92' EAST TO K-6.
MEASURED 2669.12' SOUTH TO J-7.	MEASURED 2655.30' WEST TO I-6.