

**SURVEY &
REMONUMENTATION**

APR 27 1995

COMMISSION

LAND CORNER RECORDATION CERTIFICATE
Filing Requirement of Act 74, Mich. P.A. 1970

FILED

Copy

94 NOV 28 PM 1:41

For corners in

<u>EATON</u> (County)	Located In:	Corner Code #
<u>WALTON TOWNSHIP</u>	---	---
1. Public Land Survey	T <u>1N</u> R <u>5W</u>	<u>K-9</u>
	T _____ R _____	_____
	T _____ R _____	_____
	T _____ R _____	_____
2. Property Controlling in Section	S _____ T _____ R _____	_____
	S _____ T _____ R _____	_____
3. Miscellaneous Property in Sec.	S _____ T _____ R _____	_____
	S _____ T _____ R _____	_____

LINDA M. TWITCHELL
REGISTER OF DEEDS
EATON COUNTY, MICH.

LIBER 3 PAGE 504

Register of Deeds Stamp & File Number

4. Lot No. _____, Recorded Plat _____
5. Private Claims _____

I, DAVID R. LOHR, in a field survey on OCT. 10, 1994, do hereby certify that under requirements of P.A. 74, Michigan P.A. of 1970, the corner points mentioned in lines 1 and 2 above were in conformance with regulations and rules therefore as required in the current manual of survey instructions of the United States Department of the Interior, Bureau of Land Management or by a decree of a Court of Law and/or that the corner points mentioned in lines 3, 4 and 5 above were in conformance with the rules of the Michigan Board of Land Surveyors or by a Decree of a Court of Law; established, re-established, monumented, re-monumented, recovered, found as expressed below:

NOTE: Not more than 4 corners, all in the same town and range, may be recorded on this certificate.

	A	B	C	D	E	F	G	H	I	J	K	L	M
2	6	5	4	3	2	1							
3													
4	7	8	9	10	11	12							
5													
6	18	17	16	15	14	13							
7													
8	19	20	21	22	23	24							
9													
10	30	29	28	27	26	25							
11													
12	31	32	33	34	35	36							
13													

A. Description of original monument and accessories and/or subsequent restoration:


- K-9: 1. POST SET IN 1825 BY SILVESTER SIBLEY - WITNESSED BY:
BEECH 12" S 55° E 22 LINKS (14.52')
BEECH 12" N 61° W 25 LINKS (16.50')
SHOWS 40 AND 80 CH. NORTH AND SOUTH. SHOWS 39.91 CH. (2634.06')
EAST TO L-9 AND 79.81 CH. (5267.46') EAST TO M-9.
2. CORNER REFERRED TO AS "STONE" IN SURVEY DATED 11/12/1876
BY COUNTY SURVEYOR, OSCAR CHURCH. RECORDED IN BOOK 1, PAGE 244.
NO WITNESSES GIVEN: NO DISTANCES GIVEN TO ADJOINING CORNERS.
(OVER)

B. Description of corner evidence found and/or method applied in restoring or reestablishing corner:

K-9: FOUND 1" OD x 18" PIPE IN MONUMENT BOX. REMOVED PIPE, EXCAVATED INSIDE MONUMENT BOX TO DEPTH OF 24". FOUND ANOTHER 1" PIPE UNDER 1" PIPE AT SURFACE, ON NORTHWESTLY SIDE OF A LARGE STONE. ACCEPTED 1" PIPE AS LOCATION OF CORNER. MEASURED SOUTH LINE OF SECTION AND FOUND DISTANCE TO BE 2652.90 FT. TO L-9. SET 3/4" X 24" STANDARD REMON BAR IN LOCATION OF 1" PIPE.

C. Description of monument for corner and accessories established to perpetuate locating the position of the corner:

K-9: SET 3/4" X 24" STANDARD REMON BAR WITH PA 345 CAP #30090 IN MON. BOX.
WITNESSED BY:
FD. N/T #25832 W/S OF 48" WILLOW AZ. 32° 80.74'
SET N/T #30090 QUAD 20" MAPLE AZ. 75° 184.51'
FD. N/T #25832 N/S P. POLE AZ. 110° 100.80'
FD. N/T #25832 E/S 18" WALNUT AZ. 189° 114.02'
SET N/T #30090 E/S P. POLE AZ. 334° 186.57'

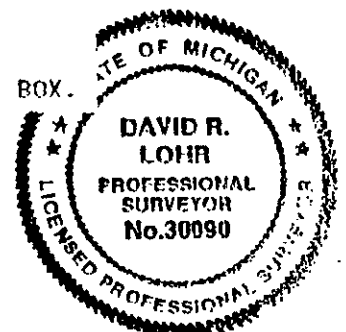

Signed by David R. Lohr Date Nov. 21, 1994

Surveyor's Michigan License No. 30090

Page 2

K-9: PART A - CONTINUED

3. CORNER REFERRED TO ON EATON COUNTY ROAD COMMISSION BELLEVUE ROAD PLANS DATED MARCH 19, 1923 BY H.A. WILLIAMS

"SECTION CORNER COM. TO SECTION 23,24,25 AND 26
 STA 53 + 9.5 (MEAS. FROM THE WEST) - 2 1/2" X 4" STEEL SHAFT,
 TRIPLE MAPLE S 39 1/2° W 44.3'
 MAPLE (36") N 60 °E 39'
 ELM (15") S 3 1/2° E 39.3'

4. CORNER REFERENCED IN SURVEY RECORDED IN LIBER 3 PAGE 676, DATED

JULY 2, 1984 BY ROBERT REED PS #19004.

"7/8" PIPE" WITNESSED BY:

13" ASH N 37° 48' 55" W, 51.28'
 15" WILLOW N 33° 19' 01" E, 80.82'
 7" ASH S 09° 48' 55" W, 114.08'

5. CORNER REFERENCED IN SURVEY RECORDED IN LIBER 4 PAGE 969,
 DATED SEPTEMBER 15, 1987 BY LARRY BRYAN, PS #25832.
 FOUND 3/4" PIPE C/L BELLEVUE & MATHEWS ROADS. WITNESSED BY:

SET N & T #25832 W SIDE 48" WILLOW, N 35° E, 80.82'
 SET N & T #25832 E SIDE 18" WALNUT, S 10° W, 114.08'
 SET N & T #25832 N SIDE POWER POLE, S 80° E, 100.80'

SURVEY SHOWS DISTANCE NORTH TO K-8 OF 2644.81 FT.

6. CORNER REFERENCED ON LCRC BY LARRY BRYAN, PS #24832 RECORDED IN
 LIBER 3, PAGE 52, DATED OCTOBER 14, 1987.
 FOUND 3/4" PIPE WITNESSED BY:

SET N & T #25832 W SIDE 48" WILLOW, N-35° E, 80.82'
 SET N & T #25832 E SIDE 18" WALNUT, S 10° W, 114.08'
 SET N & T #25832 N SIDE POWER POLE, S 80° E, 100.80'

7. NO OTHER REFERENCES FOUND.