

SURVEY & REMONUMENTATION

DEC 16 1996

COMMISSION

LAND CORNER RECORDATION CERTIFICATE

Filing Requirement of Act 74, Mich. P.A. 1970

FILED
copy

96 OCT 30 PM 1:46

For corners in

<u>EATON</u> (County)	Located In:	Corner Code #
<u>WALTON TOWNSHIP</u>	T <u>1N</u> R <u>5W</u>	<u>L-9</u>
1. Public Land Survey	T _____ R _____	_____
	T _____ R _____	_____
	T _____ R _____	_____
2. Property Controlling in Section	S _____ T _____ R _____	_____
	S _____ T _____ R _____	_____
3. Miscellaneous Property in Sec.	S _____ T _____ R _____	_____
	S _____ T _____ R _____	_____

LINDA M. TWITCHELL
REGISTER OF DEEDS
EATON COUNTY, MICH.

Liber 3, pg 732

Register of Deeds Stamp & File Number

4. Lot No. _____, Recorded Plat _____
5. Private Claims _____

	A	B	C	D	E	F	G	H	I	J	K
2	6	5	4	3	2						
3											
4	7	8	9	10	11						
5											
6	18	17	16	15	14						
7											
8	19	20	21	22	23						
9											
10	30	29	28	27	26						
11											
12	31	32	33	34	35						
13											

I, DAVID R. LOHR, in a field survey on OCT. 10, 19 94, do hereby certify that under requirements of P.A. 74, Michigan P.A. of 1970, the corner points mentioned in lines 1 and 2 above were in conformance with regulations and rules therefore as required in the current manual of survey instructions of the United States Department of the Interior, Bureau of Land Management or by a decree of a Court of Law and/or that the corner points mentioned in lines 3, 4 and 5 above were in conformance with the rules of the Michigan Board of Land Surveyors or by a Decree of a Court of Law; established, re-established, monumented, re-monumented, recovered, found as expressed below:

NOTE: Not more than 4 corners, all in the same town and range, may be recorded on this certificate.

A. Description of original monument and accessories and/or subsequent restoration:

L-9: 1. POST SET IN 1825 BY SYLVESTER SIBLEY - WITNESSED BY:
BEECH 7" S 17° E, 14 LINKS (9.24')
IRONWOOD 6" N 31° W, 16 LINKS (10.56')


2. CORNER REFERRED IN SURVEY DATED 11/17/1876 BY SURVEYOR OSCAR CHURCH. RECORDED IN VOLUME 1, PAGE 244, NO WITNESSES SHOWN - 40.00 CHAINS WEST OF M-9 Shows "Stone"
CONTINUED ON BACK

B. Description of corner evidence found and/or method applied in restoring or reestablishing corner:

L-9: FOUND 3/4" OD x 14" PIPE IN MONUMENT BOX CENTERLINE OF BELLEVUE AND BAUM ROADS. REMOVED PIPE AND EXCAVATED INTERIOR OF MONUMENT BOX. TO DEPTH OF 36". FOUND NOTHING. MEASURED SOUTH LINE OF SECTION AND FOUND THIS PIPE TO BE IN CLOSE ACCORD WITH GLO DISTANCES. MEASURED WEST 2652.90 FT. AND EAST 2649.88 FT. ACCEPTED LOCATION OF 3/4" PIPE AND SET 3/4" X 24" STANDARD REMON. BAR IN ITS LOCATION.

C. Description of monument for corner and accessories established to perpetuate locating the position of the corner:

L-9: SET 3/4" X 24" STANDARD REMON BAR/PA 345 CAP #30090 IN MONUMENT BOX WITNESSED BY:
NORTHWEST CORNER MBTC BOX AZ. 49° 45.27'
SET N/T #30090 N/S 50" MAPLE AZ. 103° 129.80'
NORTHWEST COR. HOUSE FOUND. AZ. 134° 105.92'
NORTHWEST COR. MACHINE SHED AZ. 184° 213.82'
SET N/T #30090 W/S POWER POLE AZ. 349° 172.89'

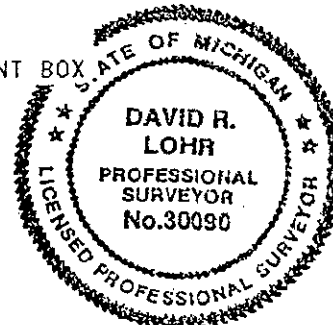

Signed by David R. Lohr

Date Nov. 21, 1994

Surveyor's Michigan License No. 30090

P.A. 345 EATON COUNTY

FORM APPROVED BY MICHIGAN STATE BOARD OF LAND SURVEYORS, JAN. 9-19-96 9-26-96 REVISED MAY

PEER APPROVED 9/26/96 RL

REVISED JJ

L-9: PART A CONTINUED

3. CORNER REFERENCED IN SURVEY RECORDED IN LIBER 3, PAGE 598,
DATED 11-2-83, BY ROBERT REED PS #19004. NO MENTION OF MONUMENT.
"RESTORED GLO MONUMENTS AND ACCESSORIES. SOUTH 1/4 CORNER"
WITNESSED BY: TELEPHONE POLE NNW 171.90'
 MBT PED NE 45.3'
 NW CORNER HOUSE SE 106.0

4. CORNER REFERENCED IN SURVEY RECORDED IN LIBER 3, PAGE 676 BY REED,
DATED JULY 2, 1984 AS 1" PIPE WITNESSED BY SAME AS ITEM HA-3

5. CORNER REFERENCED ON LCRC BY LARRY BRYAN PS #25832 RECORDED IN
LIBER 3, PAGE 52, DATED OCTOBER 14, 1987. "FOUND 1" PIPE"
witnessed by:
 SET NAIL AND TAG #25832 E/S TELEPHONE POLE, N 15 W 172.09'
 MBT PED TOP/CENTER N 45 E 45.05'
 NW CORNER OF HOUSE S 30 E 105.09'

6. CORNER REFERENCED IN SURVEY BY LARRY BRYAN, RECORDED IN LIBER 4,
PAGE 970, AND DATED SEPTEMBER 15, 1987. SAME WITNESSES AS IN
ITEM A-5. SHOWS DISTANCE TO WEST OF 2652.87 FT.