

**SURVEY & REMONUMENTATION**

DEC 1 6 1996

**COMMISSION**

**LAND CORNER RECORDATION CERTIFICATE**  
Filing Requirement of Act 74, Mich. P.A. 1970

FILED  
copy  
96 OCT 30 PM 1:46

For corners in

EATON COUNTY  
(County)

Located In:

Corner Code #

WALTON TOWNSHIP

1. Public Land Survey	T	<u>1N</u>	R	<u>5W</u>	<u>M-6</u>
	T		R		
	T		R		
	T		R		
2. Property Controlling in Section	S		T		
	S		T		
3. Miscellaneous Property in Sec.	S		T		
	S		T		

LINDA M. TWITCHELL  
REGISTER OF DEEDS  
EATON COUNTY, MICH.

Liber 3 pg. 733

Register of Deeds Stamp & File Number

4. Lot No. \_\_\_\_\_, Recorded Plat \_\_\_\_\_  
5. Private Claims \_\_\_\_\_

A	B	C	D	E	F	G	H	I	J	K	L
2	6	5	4	3	2	1					
3											
4	7	8	9	10	11	12					
5											
6	18	17	16	15	14	13					
7											
8	19	20	21	22	23	24					
9											
10	30	29	28	27	26	25					
11											
12	31	32	33	34	35	36					
13											

I, DAVID R. LOHR, in a field survey on 10-7-94 E 8-13-, 19 96, do hereby certify that under requirements of P.A. 74, Michigan P.A. of 1970, the corner points mentioned in lines 1 and 2 above were in conformance with regulations and rules therefore as required in the current manual of survey instructions of the United States Department of the Interior, Bureau of Land Management or by a decree of a Court of Law and/or that the corner points mentioned in lines 3, 4 and 5 above were in conformance with the rules of the Michigan Board of Land Surveyors or by a Decree of a Court of Law; established, re-established, monumented, re-monumented, recovered, found as expressed below:

**NOTE: Not more than 4 corners, all in the same town and range, may be recorded on this certificate.**

A. Description of original monument and accessories and/or subsequent restoration:


- M-6: 1. POST SET BY SYLVESTER SIBLEY, U.S. DEP. SURVEYOR IN 1825. WITNESSED BY BEECH 20" S 42 W 30 lks (19.80') BEECH 6" N 63 1/2 W 18 lks (11.88')
2. CORNER REFERENCED IN SURVEY BY WM. SIMPSON, CO. SURVEYOR, DATED NOV. 1878, RECORDED IN VOL 1 PG. 150-151. "STONE & CROCKERY" AT DISTANCE OF 40.25 CHAINS (2656.5') FROM M-5. NO WITNESSES GIVEN.
3. NO OTHER REFERENCES FOUND.

B. Description of corner evidence found and/or method applied in restoring or reestablishing corner:

M-6: EXCAVATED A TRENCH 12" WIDE X 4.0' LONG ALONG TOWNSHIP LINE CENTERED ON FENCELINE TO WEST, THRU 6" OF BIT. AND 12" OF GRAVEL TO UNDISTURBED ORIGINAL GROUND(CLAY). NO TOPSOIL PRESENT. FOUND NOTHING. CORNER DETERMINED TO BE LOST. SET CORNER MIDWAY BETWEEN M-5 AND M-7 ON STANDARD TOWNSHIP LINE. CORNER FALLS 1.5 FT. NORTH OF FENCELINE TO WEST, AND 2.0 FT. EAST C/L COCHRAN ROAD. SET 3/4" X 24" STANDARD REMON. BAR WITH PA #345 CAP/#30090 IN MON. BOX. MEASURED NORTH 2651.64 FT. TO M-5 AND SOUTH 2651.64 TO M-7.

C. Description of monument for corner and accessories established to perpetuate locating the position of the corner:

M-6: SET 3/4" X 24" STANDARD REMON. BAR/PA #345 CAP #30090 IN MON. BOX MID-WAY ON STANDARD TOWNSHIP LINE. WITNESSED BY:  
 SET N&T 30090 S/S POLE AZ. 141DEG. 62.33'  
 NW CORNER HOUSE AZ. 138DEG. 164.95'  
 SET N&T 30090 W/S 14" WALNUT. AZ. 174DEG. 184.02'  
 SET N&T 30090 E/S 46" CATALPA AZ. 202DEG. 81.29'  
 SET N&T 30090 NE/S POST AZ. 269DEG. 34.49'  
 A-6 BROOKFIELD AZ. 180DEG. 49.30'

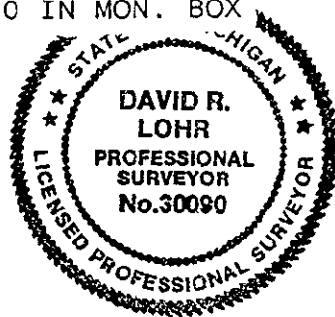

Signed by David R. Lohr Date Aug. 27, 1996