

REMONUMENTATION

DEC 1 2 1997

COMMISSION

EATON COUNTY REMONUMENTATION

LAND CORNER RECORDATION CERTIFICATE
Filing Requirement of Act 74, Mich. P.A. 1970

FILED

copy

97 DEC -2 AM 10:30

For Corners in EATON (county) Located In: Corner Code #
1. Public Land Survey T 1N R 6W A-2
WEST 1/4 CORNER
SECTION 6
BELLEVUE TOWNSHIP
ON RANGE LINE
2. Property Controlling S T R
in Section S T R
3. Miscellaneous S T R
Property in Sec. S T R
4. Lot No Recorded Plat
5. Private Claims

LINDA M. TWITCHELL
REGISTER OF DEEDS
EATON COUNTY, MICH.

LIBER 3 PAGE 867

Register of Deeds Stamp & File Number

Brian Reynolds, in a field survey on 31 JULY, 1997 do hereby certify that under requirements of P.A. 74, Michigan P.A. of 1970, the corner points mentioned in lines 1 and 2 above were in conformance with regulations and rules therefore as required in the current manual of survey instructions of the United States Department of the Interior, Bureau of Land Management or by a decree of a Court of Law and/or that the corner points mentioned in lines 3, 4, and 5 above were in conformance with the rules of the Michigan Board of Land Surveyors or by a Decree of a Court of Law; established, re-established, monumented, re-monumented, recovered, found as expressed below.

Table with 12 rows and 12 columns labeled A through L. Contains numbers 1-36 in a grid pattern.

NOTE: Not more than 2 corners, all in the same town and range, may be recorded on this certificate.


- 1. GENERAL LAND OFFICE: JOHN MULLETT, D.S., 1825 (T1N, R6W, P. 495) "40.00 SET 1/4 SEC. POST" ELM 16 S40W 13 Do. 10 N40W 09
2. BARRY COUNTY SURVEYOR RECORDS: BOWEN, 13-14-15 NOV. 1878 (L.1,267) "SET STONE & BRICK" (FOR M-2 T1N, R7W) NO WITNESSES GIVEN
3. EATON COUNTY SURVEYOR: OSCAR CHURCH, 8 JUNE, 1875 (V. 1, P. 230-231) "STAKE ESTABLISHED ACCORDING TO LAW" BEECH 8 S48E 98 Do. 3 S62E 43 1/2
*** NO OTHER HISTORICAL INFORMATION, PUBLIC OR PRIVATE, AVAILABLE FOR THIS CORNER ***

3. Description of corner evidence found and/or method applied in restoring or reestablishing corner: FOUND NO MAGNETIC EVIDENCE OF CORNER MONUMENTATION. EXCAVATION REVEALED NOTHING. CORNER LIES IN A SLIGHT FILL AREA. ANY EVIDENCE OF CORNER MONUMENTATION MAY HAVE BEEN DESTROYED BY ROAD CONSTRUCTION. FOUND STONE (TITLE CORNER) BY BARRY COUNTY SURVEYOR FRANK BOWEN (FROM SURVEY OF SECTION 1, T1N, R7W ITEM # 2 ABOVE). HELD STONE AND PREVIOUSLY APPROVED A-1 FOR RANGE LINE, INTERSECTED RANGE LINE WITH 1/4 LINE OCCUPATION FROM THE EAST. POSITION THUS ESTABLISHED PROVES CONSISTENT WITH BOWEN'S SURVEY (FOR RANGE LINE) AND IS ALSO CONSISTENT WITH 1/4 LINE OCCUPATION AND CHURCH'S SURVEY OF SECTION 6.

ACCEPTED AS PROPER RESTORATION OF CORNER POSITION. SET STANDARD EATON COUNTY REMONUMENTATION MONUMENT (3/4" X 36" IRON) WITH PLASTIC CAP.

- 4. Description of monument for corner and accessories established to perpetuate locating the position of the corner: SET STANDARD EATON COUNTY REMONUMENTATION MONUMENT (3/4" X 36" IRON) WITH PLASTIC CAP. SET 20d NAIL W/PLASTIC TAG IN THE EAST SIDE OF A 12" ASH S09°E 87.09' SET 20d NAIL W/PLASTIC TAG IN THE WEST SIDE OF AN 8" TRIPLE ASH S27°E 37.81' SET 20d NAIL W/PLASTIC TAG IN THE WEST SIDE OF A 6" ASH S19°E 44.04' SET 20d NAIL W/PLASTIC TAG IN THE EAST SIDE OF A UTILITY POLE S40°E 136.10' SET 20d NAIL W/PLASTIC TAG IN THE EAST SIDE OF A 24" BASSWOOD S10°W 237.69' +/- EAST OF NORTH-SOUTH GRAVEL CENTERLINE A-2, T1N, R7W, LIES S00°07'30"W 99.44' A-1, T1N, R6W (TOWNSHIP CORNER) LIES N00°07'30"E 2764.47' A-3, T1N, R6W, LIES S00°02'12"W 2655.05'

P.A. 345 EATON COUNTY PEER APPROVED 9/18/97 M

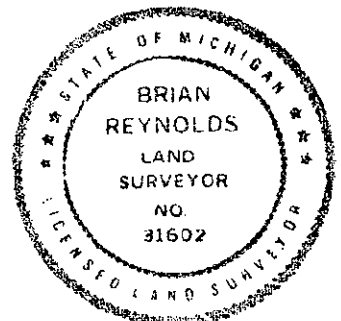

Signed by [Signature] Surveyor's Michigan License No 31602

Date DEC 1ST 1997