

LAND CORNER RECORDATION CERTIFICATE
Filing Requirement of Act 74, Mich. P.A. 1970

97 OCT 14 PM 12:46

For Corners in EATON Located In: _____ Corner Code # _____
(county)

1. Public Land Survey T 1N R 6W _____ B-3
1/4 CORNER COMMON TO T _____ R _____
SECTIONS 6 & 7 T _____ R _____
BELLEVUE TOWNSHIP T _____ R _____

2. Property Controlling S _____ T _____ R _____
in Section S _____ T _____ R _____

3. Miscellaneous S _____ T _____ R _____
Property in Sec. S _____ T _____ R _____

4. Lot No _____, Recorded Plat _____

5. Private Claims _____

LINDA M. TWITCHELL
REGISTER OF DEEDS
EATON COUNTY, MICH.

Liber 3 pg 817

Register of Deeds Stamp & File Number

I, Brian Reynolds, in a field survey on 10 JULY, 1997 do hereby certify that under requirements of P.A. 74, Michigan P.A. of 1970, the corner points mentioned in lines 1 and 2 above were in conformance with regulations and rules therefore as required in the current manual of survey instructions of the United States Department of the Interior, Bureau of Land Management or by a decree of a Court of Law and/or that the corner points mentioned in lines 3, 4, and 5 above were in conformance with the rules of the Michigan Board of Land Surveyors or by a Decree of a Court of Law; established, re-established, monumented, re-monumented, recovered, found as expressed below.

A	B	C	D	E	F	G	H	I	J	K	L	M
2	6	5	4	3	2	1						
3												
4	7	8	9	10	11	12						
5												
6	18	17	16	15	14	13						
7												
8	19	20	21	22	23	24						
9												
10	30	29	28	27	26	25						
11												
12	31	32	33	34	35	36						
13												

NOTE: Not more than 2 corners, all in the same town and range, may be recorded on this certificate.

A. Description of original monument and accessories and/or subsequent restoration:


- GENERAL LAND OFFICE: MUSGROVE EVANS, D.S., MARCH, 1826 (T1N, R6W, P. 519) "40.00 SET 1/4 SEC POST" SUGAR 14 N25W 37 W. OAK 20 S85W 20
- COUNTY SURVEYOR RECORDS: FRANK DAVIS, MAY 1870, (V. 1, P. 106-107) "STONE & C. F. O. B. T." ELM 24 N75 1/2E.149
- COUNTY SURVEYOR RECORDS: OSCAR CHURCH, 8 JUNE, 1878 (V. 1, P. 230-231), "SEE PAGE 106"
- PRIVATE NOTES OF SURVEY: ROBERT R. CARR, P. S., #20704, c. 1983, CALLS FOR PIPE. NO WITNESSES
- PRIVATE NOTES OF SURVEY: WILLIAM K. CRANE, P. S. #29243, c. 1993, CALLS A DISTANCE OF 2800.35' TO A-3 AND A DISTANCE OF 2692.19' TO B-4. NO WITNESSES

B. Description of corner evidence found and/or method applied in restoring or reestablishing corner:

FOUND PIPE ON NORTH SIDE OF ABANDONED ROAD 2'+/- WEST OF OLD CONCRETE BRIDGE, AS PER CARR'S NOTES (ITEM #4 ABOVE). TRAVERSED ALL OF SECTIONS 6 & 7, TYING IN OCCUPATION LINES AS REFERRED TO ON SURVEYS BY DAVIS AND CHURCH (ITEMS #2 & #3 ABOVE). OCCUPATION AND REESTABLISHED POSITIONS AT B-5 (FOUND STONE) AND B-4 (FOUND STACKED STONES & COLUMN OF COAL) POINT TO A POSITION 33'-35' EAST OF FOUND PIPE. BEGAN EXCAVATION AT 34' EAST OF FOUND PIPE, AN AREA 5'+/- EAST-WEST AND 7'+/- NORTH-SOUTH (COVERING ALL OF THE ABANDONED TRAIL NORTH-SOUTH). AT A DEPTH OF 2'+ FOUND FOUR PIECES OF BROKEN BRICK LOCALIZED, 2'+/- NORTH OF CENTERLINE OF OLD ROAD. RAISED FOUND BRICK WITH 1/2" x 18" IRON ROD. LOCATION OF FOUND BRICK FIT VERY WELL WITH 1/8 LINE OCCUPATION TO THE EAST AND REESTABLISHED C-3 (FOUND STONES & BRICK) AND A LINE FROM B-5 THROUGH B-4. ACCEPTED FOUND BROKEN BRICK AS BEST AVAILABLE EVIDENCE OF CORNER POSITION. REPLACED 1/2" IRON OVER BROKEN BRICKS WITH STANDARD EATON COUNTY REMONUMENTATION MONUMENT.

C. Description of monument for corner and accessories established to perpetuate locating the position of the corner:

- SET STANDARD EATON COUNTY REMONUMENTATION MONUMENT (3/4" X 36" IRON) WITH PLASTIC CAP.
- SET 1/2" x 18" IRON W/TRVERSE POINT CAP (ON SOUTHEAST EDGE OF BRIDGE) S77°W 14.60'
- SET 20d NAIL W/PLASTIC TAG IN THE SOUTH SIDE OF A 10" OAK N81°E 22.12'
- SET 20d NAIL W/PLASTIC TAG IN THE EAST SIDE OF A 14" OAK N01°W 6.55'
- NORTHEAST CORNER OF CONCRETE BRIDGE N68°W 15.70'
- SET 1/2" x 18" IRON W/TRVERSE POINT CAP S49°E 6.60'
- 2'+/- NORTH OF THE CENTERLINE OF ABANDONED ROAD
- 4' EAST OF THE EAST END OF CONCRETE BRIDGE
- FOUND 1/2" PIPE N89°28'55"W 33.78'

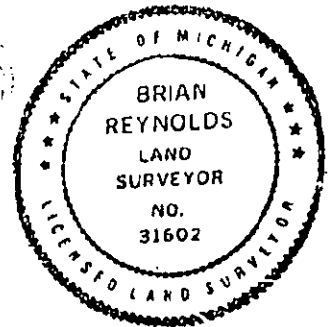

P.A. 345 EATON COUNTY
PEER APPROVED 7/22/97 AL

Signed by [Signature]
Surveyor's Michigan License No. 31602

Date 8-15-97

FORM APPROVED BY MICHIGAN STATE BOARD OF LAND SURVEYORS. JAN. 26, 1971
REVISED MAY 14, 1975 REVISED JANUARY, 1983 REVISED OCTOBER 1995

PRIVATE
RECORDS

GLO
NOTES

P.A. 132
SURVEYS

LO
APB

PREVIOUS
P.A. 74

COUNTY SUR.
RECORDS