

REMONUMENTATION

EATON COUNTY REMONUMENTATION

FILED

DEC 1 2 1997

LAND CORNER RECORDATION CERTIFICATE
Filing Requirement of Act 74, Mich. P.A. 1970

97 OCT 14 PM 12:46

COMMISSION

| | | |
|--|-------------------------|---------------|
| For Corners in EATON (county) | Located In: | Corner Code # |
| 1. Public Land Survey 1/4 CORNER COMMON TO SECTIONS 18 & 19 BELLEVUE TOWNSHIP | T <u>1N</u> R <u>6W</u> | <u>B-7</u> |
| | T _____ R _____ | _____ |
| | T _____ R _____ | _____ |
| | T _____ R _____ | _____ |
| 2. Property Controlling in Section | S _____ T _____ R _____ | _____ |
| | S _____ T _____ R _____ | _____ |
| 3. Miscellaneous Property in Sec. | S _____ T _____ R _____ | _____ |
| | S _____ T _____ R _____ | _____ |
| 4. Lot No _____, Recorded Plat _____ | | |
| 5. Private Claims _____ | | |

LINDA M. TWITCHELL
REGISTER OF DEEDS
EATON COUNTY, MICH.

Liber 3 pg 820

Register of Deeds Stamp & File Number

I, **Brian Reynolds**, in a field survey on **10 JULY, 1997** do hereby certify that under requirements of P.A. 74, Michigan P.A. of 1970, the corner points mentioned in lines 1 and 2 above were in conformance with regulations and rules therefore as required in the current manual of survey instructions of the United States Department of the Interior, Bureau of Land Management or by a decree of a Court of Law and/or that the corner points mentioned in lines 3, 4, and 5 above were in conformance with the rules of the Michigan Board of Land Surveyors or by a Decree of a Court of Law; established, re-established, monumented, re-monumented, recovered, found as expressed below.

| A | B | C | D | E | F | G | H | I | J | K | L | M |
|----|----|----|----|----|----|----|---|---|---|---|---|---|
| 2 | 6 | 5 | 4 | 3 | 2 | 1 | | | | | | |
| 3 | | | | | | | | | | | | |
| 4 | 7 | 8 | 9 | 10 | 11 | 12 | | | | | | |
| 5 | | | | | | | | | | | | |
| 6 | 18 | 17 | 16 | 15 | 14 | 13 | | | | | | |
| 7 | | | | | | | | | | | | |
| 8 | 19 | 20 | 21 | 22 | 23 | 24 | | | | | | |
| 9 | | | | | | | | | | | | |
| 10 | 30 | 29 | 28 | 27 | 26 | 25 | | | | | | |
| 11 | | | | | | | | | | | | |
| 12 | 31 | 32 | 33 | 34 | 35 | 36 | | | | | | |
| 13 | | | | | | | | | | | | |

NOTE: Not more than 2 corners, all in the same town and range, may be recorded on this certificate.


- A. Description of original monument and accessories and/or subsequent restoration:
- GENERAL LAND OFFICE: MUSGROVE EVANS, D.S., APRIL 1826 (T1N, R6W, P.518) "40.00 SET 1/4 SEC. POST"
 - OAK 36 N22 1/2W 46 SYCAMORE 18 S63W 30
 - COUNTY ROAD COMMISSION: 1965 ROAD PLANS, NO NAME, "P.I. STA. 27+17 IRON ROD" CON. AN. POST S. 33.0' WOOD AN. POST N. 33.0'

*** NO OTHER HISTORICAL INFORMATION, PUBLIC OR PRIVATE, AVAILABLE FOR THIS CORNER ***

B. Description of corner evidence found and/or method applied in restoring or reestablishing corner:
FOUND RAIL ROAD SPIKE UNDER BITUMINOUS ROAD ON TOP OF GRAVEL SUB-GRADE. DISTANCE TO A-7 MATCHES REASONABLY WELL WITH ROAD PLANS AS DOES WITNESS TO WOOD ANCHOR POST NORTH 33'. ACCEPTED FOUND RAILROAD SPIKE AS BEST AVAILABLE EVIDENCE OF CORNER POSITION. REPLACED RAILROAD SPIKE WITH STANDARD EATON COUNTY REMONUMENTATION MONUMENT.

C. Description of monument for corner and accessories established to perpetuate locating the position of the corner:
SET STANDARD EATON COUNTY REMONUMENTATION MONUMENT (3/4" X 36" IRON) WITH PLASTIC CAP.
SET 20d NAIL W/PLASTIC TAG IN THE EAST SIDE OF A WOOD CORNER POST N02°W 33.04'
SET 20d NAIL W/PLASTIC TAG IN THE SOUTHWEST SIDE OF A 24" POPLAR N63°W 47.08'
SET 20d NAIL W/PLASTIC TAG IN THE SOUTH SIDE OF A WOOD CORNER POST N78°E 163.43'
SET 20d NAIL W/PLASTIC TAG IN THE EAST SIDE OF A WOOD CORNER (GATE) POST S02°W 41.02'
CORNER LIES 2'+/- NORTH OF EAST-WEST PAINTED CENTERLINE (ASSYRIA HIGHWAY)
TOP CENTER OF AN ALUMINUM WELL CAP N43°E 133.82'
TOP CENTER OF A CONCRETE FENCE POST S23°E 45.21'
1.5'+/- EAST OF FENCES RUNNING NORTH-SOUTH.

P.A. 345 EATON COUNTY
PEER APPROVED 7/22/97 W

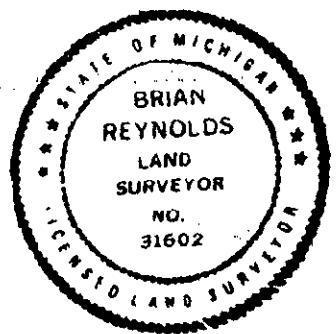

Signed by [Signature]
Surveyor's Michigan License No 31602

Date 8-15-97
FORM APPROVED BY MICHIGAN STATE BOARD OF LAND SURVEYORS, JAN. 28, 1971
REVISED MAY 14, 1975 REVISED JANUARY, 1983 REVISED OCTOBER 1995