

REMONUMENTATION

DEC 1 8 1997

COMMISSIONER

EATON COUNTY REMONUMENTATION

LAND CORNER RECORDATION CERTIFICATE
Filing Requirement of Act 74, Mich. P.A. 1970

FILED

copy
97 DEC -2 AM 10:30

For Corners in EATON (county) Located In: 2N 6W Corner Code # C-13 C-1
1. Public Land Survey T 1N R 6W
CORNER COMMON TO T R
SECTIONS 5 & 6 T R
BELLEVUE TOWNSHIP T R
ON TOWNSHIP LINE
2. Property Controlling S T R
in Section S T R
3. Miscellaneous S T R
Property in Sec. S T R
4. Lot No. Recorded Plat
5. Private Claims

LINDA M. TWITCHELL
REGISTER OF DEEDS
EATON COUNTY, MICH.

LIBER 3 PAGE 870

Register of Deeds Stamp & File Number

Brian Reynolds, in a field survey on 31 OCT, 1997 do hereby certify that under requirements of P.A. 74, Michigan P.A. of 1970, the corner points mentioned in lines 1 and 2 above were in conformance with regulations and rules therefore as required in the current manual of survey instructions of the United States Department of the Interior, Bureau of Land Management or by a decree of a Court of Law and/or that the corner points mentioned in lines 3, 4, and 5 above were in conformance with the rules of the Michigan Board of Land Surveyors or by a Decree of a Court of Law; established, re-established, monumented, re-monumented, recovered, found as expressed below.

Table with 12 columns (A-L) and 13 rows for recording survey data.

NOTE: Not more than 2 corners, all in the same town and range, may be recorded on this certificate.


- A. Description of original monument and accessories and/or subsequent restoration:
1. (FOR C-13 T2N R6W) GENERAL LAND OFFICE: JOHN MULLETT, D.S. 1825 (T1N,R6W,P.493)
"80.00 SET POST COR. SECT. 31 & 32" ELM 12 N36E 19 B. ASH 12 N45 1/2W 17
2. (FOR C-1 T1N R6W) GENERAL LAND OFFICE: MUSGROVE EVANS, D.S., APRIL, 1826 (T1N, R6W, P. 517)
"82.61 INTERSECT N. BDY. 32 LKS. W. OF POST. SET POST FOR CORNER SECS. 5 & 6."
B. ASH 18 S45W 24 BEECH 10 S57E 17
3. COUNTY SURVEYOR RECORDS: OSCAR CHURCH, JUNE 8, 1878 (V.1, P.231) "STAKE, FOUND ROOTS OF BEARING TREE" NO WITNESSES GIVEN.

*** NO OTHER HISTORICAL INFORMATION, PUBLIC OR PRIVATE, AVAILABLE FOR THIS CORNER ***

3. Description of corner evidence found and/or method applied in restoring or reestablishing corner:
FOUND NO MAGNETIC EVIDENCE OF CORNER MONUMENTATION. TRAVERSED ALL OF SECTION 6, TYING IN OCCUPATION THROUGHOUT & A-13, B-13, & C-13 KALAMO TOWNSHIP (TOWNSHIP LINE). BY THE LOCATION OF HILL ROAD (PRESUMED TO HAVE BEEN BUILT TO CENTER ON SECTION LINE) AND THE DISTANCE TO B-1, IT IS CLEAR THAT THE DISTANCE REPORTED IN THE GENERAL LAND OFFICE NOTES FROM C-1 TO C-13 T2N R6W IS IN ERROR BY ROUGHLY 66 FEET. I BELIEVE THAT DUE TO A NOTEKEEPING ERROR, THE TRUE FALLING IS 132 LINKS. SET STANDARD EATON COUNTY REMONUMENTATION MONUMENT 3/4" X 24" IRON WITH PLASTIC CAP) ON TOWN LINE AND 87.12 FEET WEST OF C-13 T2N R6W AND INSTALLED MONUMENT BOX.

2. Description of monument for corner and accessories established to perpetuate locating the position of the corner:
SET STANDARD EATON COUNTY REMONUMENTATION MONUMENT (3/4" X 36" IRON) WITH PLASTIC CAP IN MONUMENT BOX.
FOUND NAIL IN THE NORTHWEST SIDE OF A UTILITY POLE S939W 65.26
FOUND NAIL IN THE NORTHEAST SIDE OF A UTILITY POLE S78E 221.00'
1/2" X 18" IRON W/"TRAVERSE POINT" CAP (BL1-2-3-TP) N11E 8.91
1'-/- NORTH OF EAST-WEST PAINTED CENTERLINE (5 POINT HIGHWAY)
SET 1/2" X 18" IRON W/"TRAVERSE POINT" CAP S27E 40.01'
CENTERLINE GRAVEL ROAD SOUTH (HILL ROAD) LIES 3'+/- WEST
C-13, T2N, R6W LIES S89°14'05"E 87.12'
B-13, T2N, R6W LIES N89°14'05"W 2565.67'
3-1, T1N, R6W LIES N89°14'05"W 2648.80'
C-2, T1N, R6W LIES S00°28'42"W 2764.96'

P.A. 345 EATON COUNTY
PEER APPROVED 9/18/97 ML

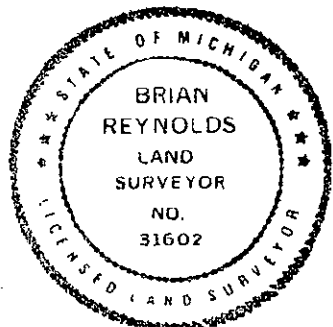

Signed by [Signature]
Surveyor's Michigan License No 31602

Date DEC 1ST, 1997