

LAND CORNER RECORDATION CERTIFICATE  
Filing Requirement of Act 74, Mich. P.A. 1970

97 OCT 14 PM 12:46

For Corners in EATON Located In: \_\_\_\_\_ Corner Code # \_\_\_\_\_  
(county)

1. Public Land Survey T 1N R 6W C-3  
CORNER COMMON TO \_\_\_\_\_  
SECTIONS 5, 6, 7, & 8 \_\_\_\_\_  
BELLEVUE TOWNSHIP \_\_\_\_\_

2. Property Controlling S \_\_\_\_\_ T \_\_\_\_\_ R \_\_\_\_\_  
in Section S \_\_\_\_\_ T \_\_\_\_\_ R \_\_\_\_\_

3. Miscellaneous S \_\_\_\_\_ T \_\_\_\_\_ R \_\_\_\_\_  
Property in Sec. S \_\_\_\_\_ T \_\_\_\_\_ R \_\_\_\_\_

4. Lot No \_\_\_\_\_, Recorded Plat \_\_\_\_\_

5. Private Claims \_\_\_\_\_

LINDA M. TWITCHELL  
REGISTER OF DEEDS  
EATON COUNTY, MICH.

Liber 3 pg. 821

Register of Deeds Stamp & File Number \_\_\_\_\_

I, Brian Reynolds, in a field survey on 28 JUNE, 1997 do hereby certify that under requirements of P.A. 74, Michigan P.A. of 1970, the corner points mentioned in lines 1 and 2 above were in conformance with regulations and rules therefore as required in the current manual of survey instructions of the United States Department of the Interior, Bureau of Land Management or by a decree of a Court of Law and/or that the corner points mentioned in lines 3, 4, and 5 above were in conformance with the rules of the Michigan Board of Land Surveyors or by a Decree of a Court of Law; established, re-established, monumented, re-monumented, recovered, found as expressed below.

	A	B	C	D	E	F	G	H	I	J	K	L	M
2	6	5				4			3			2	1
3													
4	7	8				9			10			11	12
5													
6	18	17				16			15			14	13
7													
8	19	20				21			22			23	24
9													
10	30	29				28			27			26	25
11													
12	31	32				33			34			35	36
13													

NOTE: Not more than 2 corners, all in the same town and range, may be recorded on this certificate.

A. Description of original monument and accessories and/or subsequent restoration:

- GENERAL LAND OFFICE: MUSGROVE EVANS, D.S., 1825 (T1N, R6W, P.516) "80.00 SET POST COR. 5, 6, 7, & 8" BEECH 14 S76E 12 Do. 10 N56W 9
- COUNTY SURVEYOR RECORDS: FRANK DAVIS, MAY 1870 (V. 1, P.106-107) "STAKE, F. O. S." NO WITNESSES GIVEN
- COUNTY SURVEYOR RECORDS: OSCAR CHURCH, 8 JUNE, 1878 (V. 1, P.231) "SEE PAGE 106" NO WITNESSES GIVEN

\*\*\* NO OTHER HISTORICAL INFORMATION, PUBLIC OR PRIVATE, AVAILABLE FOR THIS CORNER \*\*\*


B. Description of corner evidence found and/or method applied in restoring or reestablishing corner:

FOUND 1/2" IRON INSIDE A 3/4" x 12" PIPE 3" BELOW GRAVEL ROAD GRADE. EXCAVATED WITH A BACKHOE AN AREA 6'+ EAST-WEST BY 10'+ NORTH-SOUTH, CENTERED ON FOUND IRON/PIPE. FOUND 4 MEDIUM SIZED STONES (5"- 6") FITTED TIGHTLY AROUND FOUND IRON/PIPE WITH 1/3+ OF AN OLD RED BRICK ON TOP OF STONES. THIS POSITION FIT VERY WELL WITH ALL CORRESPONDING 1/8 LINE AND 1/4 LINE OCCUPATIONS AS WELL AS DISTANCES TO CORRESPONDING CORNERS.

ACCEPTED FOUND 1/2" IRON INSIDE 3/4" x 12" PIPE SURROUNDED BY STONES AND BRICK AS BEST AVAILABLE EVIDENCE OF CORNER POSITION. LEFT STONES IN PLACE AND REPLACED FOUND IRON/PIPE WITH STANDARD EATON COUNTY REMONUMENTATION MONUMENT.

C. Description of monument for corner and accessories established to perpetuate locating the position of the corner:

- SET STANDARD EATON COUNTY REMONUMENTATION MONUMENT (3/4" X 36" IRON) WITH PLASTIC CAP.
- SET 20d NAIL W/PLASTIC TAG IN THE WEST SIDE OF AN 18" HICKORY N12°W 116.31'
- SET 20d NAIL W/PLASTIC TAG IN THE SOUTH SIDE OF A 10" ASH S75°W 47.30'
- SET 20d NAIL W/PLASTIC TAG IN THE SOUTH SIDE OF A 10" ASH S60°W 29.34'
- SET 20d NAIL W/PLASTIC TAG IN THE EAST SIDE OF A 10" CHERRY CLUSTER S21°W 71.44'
- SET 1/2" x 18" IRON W/TRVERSE POINT CAP N38°E 35.32'
- ROUGHLY ON CENTERLINE ABANDONED ROAD (TRAIL) WEST (FOLLETT HIGHWAY)
- ROUGHLY ON NORTH-SOUTH GRAVEL CENTERLINE (HILL ROAD)
- +/- NORTH OF GRAVEL CENTERLINE EAST (FOLLETT HIGHWAY)

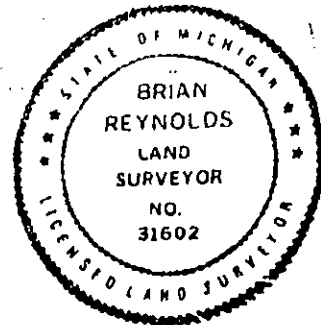

P.A. 345 EATON COUNTY  
PEER APPROVED 7/22/97 M

igned by [Signature]  
urveyor's Michigan License No 31602

Date 8-15-97

FORM APPROVED BY MICHIGAN STATE BOARD OF LAND SURVEYORS. JAN. 26, 1971  
REVISED MAY 14, 1975 REVISED JANUARY, 1983 REVISED OCTOBER 1995