

DEC 12 1997

LAND CORNER RECORDATION CERTIFICATE
Filing Requirement of Act 74, Mich. P.A. 1970

COMMISSION

97 OCT 14 PM 12:46

For Corners in EATON Located In: _____ Corner Code # _____
(county)

1. Public Land Survey T 1N R 6W C-5
CORNER COMMON TO T R
SECTIONS 7, 8, 17, & 18 T R
BELLEVUE TOWNSHIP T R

2. Property Controlling S T R
in Section S T R

3. Miscellaneous S T R
Property in Sec. S T R

4. Lot No _____, Recorded Plat _____

5. Private Claims _____

LINDA M. TWITCHELL
REGISTER OF DEEDS
EATON COUNTY, MICH.

Liber 3 pg 822

Register of Deeds Stamp & File Number

I, **Brian Reynolds**, in a field survey on **28 JUNE, 1997** do hereby certify that under requirements of P.A. 74, Michigan P.A. of 1970, the corner points mentioned in lines 1 and 2 above were in conformance with regulations and rules therefore as required in the current manual of survey instructions of the United States Department of the Interior, Bureau of Land Management or by a decree of a Court of Law and/or that the corner points mentioned in lines 3, 4, and 5 above were in conformance with the rules of the Michigan Board of Land Surveyors or by a Decree of a Court of Law; established, re-established, monumented, re-monumented, recovered, found as expressed below.

	A	B	C	D	E	F	G	H	I	J	K	L	M
2	6	5	4	3	2	1							
3													
4	7	8	9	10	11	12							
5													
6	18	17	16	15	14	13							
7													
8	19	20	21	22	23	24							
9													
10	30	29	28	27	26	25							
11													
12	31	32	33	34	35	36							
13													

NOTE: Not more than 2 corners, all in the same town and range, may be recorded on this certificate.

A. Description of original monument and accessories and/or subsequent restoration:

- GENERAL LAND OFFICE: MUSGROVE EVANS, D.S., APRIL 1826 (R6W, P.516); "SET POST FOR CORNER" BEECH 24 S26 1/2E 16 Do. 7 N44E 8
- COUNTY SURVEYOR RECORDS: FRANK DAVIS, MAY, 1870 (V. 1, P.106) "STONE & C. F. O. S." NO WITNESSES GIVEN
- COUNTY ROAD COMMISSION: WITNESS MAP, NO NAME OR DATE. RECITE THE SAME WITNESSES AS IN #1 ABOVE


*** NO OTHER INFORMATION, PUBLIC OR PRIVATE, AVAILABLE FOR THIS CORNER ***

B. Description of corner evidence found and/or method applied in restoring or reestablishing corner:

FOUND NO MAGNETIC EVIDENCE OF CORNER MONUMENTATION. TRAVERSE OF SECTIONS 7 & 18 TYING IN OCCUPATION THROUGHOUT BOTH SECTIONS WITH 1/8 LINE AND 1/4 LINE OCCUPATION DIRECTLY EAST OF C-5. EXCAVATED WITH BACKHOE AN AREA 12'+ NORTH-SOUTH AND 6'+ WEST BEGINNING AT INTERSECTION OF CENTERLINES AND WORKING WEST. FOUND A 19" x 12" x 9" FLAT SIDED, POINTED STONE IN AN UPRIGHT POSITION 12" BELOW ROAD GRADE, ENCIRCLED BY 8 SMALLER STONES WITH MULTIPLE PIECES OF A BROKEN CHINA TEA SET AROUND AND UNDER STONE. POSITION OF FOUND STONE IS CONSISTENT WITH CORRESPONDING CORNERS AND OCCUPATION THROUGHOUT THE AREA. ACCEPTED FOUND POINTED STONE AS CORNER POSITION BY COUNTY SURVEYOR FRANK DAVIS, 1870. REPLACED FOUND POINTED STONE WITH 3/4" x 36" IRON W/PLASTIC REMONUMENTATION CAP OVER A 3/4" x 36" IRON.

C. Description of monument for corner and accessories established to perpetuate locating the position of the corner:

SET STANDARD EATON COUNTY REMONUMENTATION MONUMENT (3/4" X 36" IRON) WITH PLASTIC CAP OVER A 3/4" x 36" IRON.
SET 20d NAIL W/PLASTIC TAG IN THE WEST SIDE OF A UTILITY POLE S41°E 41.64'
SET 20d NAIL W/PLASTIC TAG IN THE EAST SIDE OF A UTILITY POLE N8°E 218.97'
SET 20d NAIL W/PLASTIC TAG IN THE SOUTH SIDE OF A UTILITY POLE S77°W 130.68'
SET 20d NAIL W/PLASTIC TAG IN THE NORTH SIDE OF A UTILITY POLE N77°W 130.34'
1/2" x 18" IRON W/TRVERSE POINT CAP (BL1-5-9-TP) N02°W 462.32'
TOP CENTER (IRON) OF A CONCRETE FENCE CORNER POST S37°W 35.40'
4' +/- NORTH OF EAST-WEST GRAVEL CENTERLINE (STONE POINT HIGHWAY)
5' +/- WEST OF NORTH-SOUTH GRAVEL CENTERLINE (HILL ROAD)

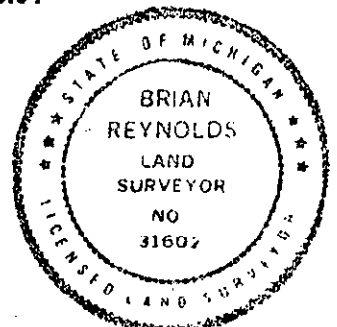

P.A. 345 EATON COUNTY
PEER APPROVED 7/22/97 M

Signed by [Signature]
Surveyor's Michigan License No 31602

Date 8-15-97