

EATON COUNTY REMONUMENTATION

FILED

LAND CORNER RECORDATION CERTIFICATE
Filing Requirement of Act 74, Mich. P.A. 1970

97 OCT 14 PM 12:47

Form with fields: For Corners in (EATON county), Located In: (T 1N R 6W), Corner Code # (C-6), and numbered sections 1-5 for survey details.

LINDA M. TWITCHELL
REGISTER OF DEEDS
EATON COUNTY, MICH.

Liber 3pg 823

Register of Deeds Stamp & File Number

I, Brian Reynolds, in a field survey on 28 JUNE, 1997 do hereby certify that under requirements of P.A. 74, Michigan P.A. of 1970, the corner points mentioned in lines 1 and 2 above were in conformance with regulations and rules therefore as required in the current manual of survey instructions of the United States Department of the Interior, Bureau of Land Management or by a decree of a Court of Law and/or that the corner points mentioned in lines 3, 4, and 5 above were in conformance with the rules of the Michigan Board of Land Surveyors or by a Decree of a Court of Law; established, re-established, monumented, re-monumented, recovered, found as expressed below.

Grid table with columns A-M and rows 2-13 containing numbers 1-36.

NOTE: Not more than 2 corners, all in the same town and range, may be recorded on this certificate.

A. Description of original monument and accessories and/or subsequent restoration:

- 1. GENERAL LAND OFFICE: MUSGROVE EVANS, D.S., APRIL 1826 (R6W, P. 515); "SET 1/4 POST" BEECH 24 S86E 27 SUGAR 8 N12W 9
2. NO RECORD FOUND IN THE COUNTY SURVEYOR'S RECORDS.
3. COUNTY ROAD COMMISSION: WITNESS MAP, NO NAME OR DATE. RECITE THE SAME WITNESSES AS IN #1 ABOVE

\*\*\* NO OTHER HISTORICAL INFORMATION, PUBLIC OR PRIVATE, AVAILABLE FOR THIS CORNER \*\*\*

B. Description of corner evidence found and/or method applied in restoring or reestablishing corner:


FOUND NO MAGNETIC EVIDENCE OF CORNER POSITION. EXCAVATED WITH BACKHOE AN AREA 12'+ EAST-WEST AND 20'+ NORTH-SOUTH BETWEEN FENCE LINE TO THE EAST AND INTERSECTION OF CENTERLINES WHICH IS 9'+/- SOUTH OF FENCE TO THE EAST. FOUND A SMALL QUANTITY OF COAL 1.5'+ BELOW ROAD GRADE ON TOP OF CLAY SUB GRADE. RAISED COAL WITH A 1/2" x 18" IRON. TRAVERSED ALL OF SECTION 18, TYING IN OCCUPATION THROUGHOUT SECTION. ACCEPTED FOUND COAL IN LINE WITH FENCE EAST, ON APPROXIMATE CENTERLINE OF NORTH-SOUTH GRAVEL ROAD, CONSISTENT WITH OCCUPATION LINES, AS BEST AVAILABLE EVIDENCE OF CORNER POSITION.

REPLACED 1/2" IRON OVER COAL WITH 3/4" X 18" IRON W/ PLASTIC CAP INSCRIBED "P.A. 345 31602" OVER A 1/2" x 18" IRON.

C. Description of monument for corner and accessories established to perpetuate locating the position of the corner:

- SET STANDARD EATON COUNTY REMONUMENTATION MONUMENT (3/4" X 36" IRON) W/PLASTIC CAP OVER 1/2" x 18" IRON.
SET 20d NAIL W/PLASTIC TAG IN THE WEST SIDE OF A UTILITY POLE N40°W 221.48'
SET 20d NAIL W/PLASTIC TAG IN THE NORTH SIDE OF A UTILITY POLE S74°W 144.93'
SET 20d NAIL W/PLASTIC TAG IN THE EAST SIDE OF A UTILITY POLE S22°W 374.66'
TOP CENTER OF A CONCRETE FENCE CORNER POST S41°W 47.95'
C-5 LIES N00°30'41"E 2641.31'
C-7 LIES S00°22'59"W 2653.38'
B-6 LIES N89°58'34"W 2657.04'

P.A. 345 EATON COUNTY
PEER APPROVED 7/22/97

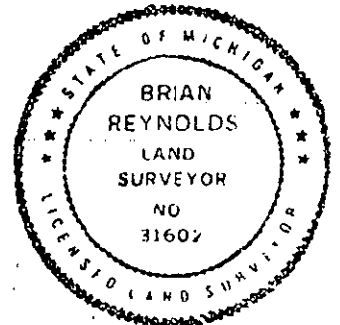

Signed by [Signature]
Surveyor's Michigan License No. 31602

Date 8-15-97