

EATON COUNTY REMONUMENTATION

FILED

LAND CORNER RECORDATION CERTIFICATE

Filing Requirement of Act 74, Mich. P.A. 1970

97 OCT 14 PM 12:47

For Corners in EATON Located In: Corner Code #
(county)

1. Public Land Survey T 1N R 6W C-7
CORNER COMMON TO T R
SECTIONS 17, 18, 19, & 20 T R
BELLEVUE TOWNSHIP T R

2. Property Controlling S T R
in Section S T R

3. Miscellaneous S T R
Property in Sec. S T R

4. Lot No. _____, Recorded Plat _____

5. Private Claims _____

LINDA M. TWITCHELL
REGISTER OF DEEDS
EATON COUNTY, MICH.

Liber 3 pg. 824

Register of Deeds Stamp & File Number

I, Brian Reynolds, in a field survey on 8 JULY, 1997 do hereby certify that under requirements of P.A. 74, Michigan P.A. of 1970, the corner points mentioned in lines 1 and 2 above were in conformance with regulations and rules therefore as required in the current manual of survey instructions of the United States Department of the Interior, Bureau of Land Management or by a decree of a Court of Law and/or that the corner points mentioned in lines 3, 4, and 5 above were in conformance with the rules of the Michigan Board of Land Surveyors or by a Decree of a Court of Law; established, re-established, monumented, re-monumented, recovered, found as expressed below.

	A	B	C	D	E	F	G	H	I	J	K	L	M
2	6	5	4	3	2	1							
3													
4	7	8	9	10	11	12							
5													
6	18	17	16	15	14	13							
7													
8	19	20	21	22	23	24							
9													
10	30	29	28	27	26	25							
11													
12	31	32	33	34	35	36							
13													

NOTE: Not more than 2 corners, all in the same town and range, may be recorded on this certificate.

A. Description of original monument and accessories and/or subsequent restoration:

1. GENERAL LAND OFFICE: MUSGROVE EVANS, D.S., APRIL, 1826 (R6W, P. 515) "SET POST FOR CORNER" BEECH 10 N70E 32 D. 14 S37E 53
2. COUNTY SURVEYOR : OSCAR CHURCH, JUNE 16, 17, & 18, 1896 "IRON BAR FOR SECTION CORNER" (NO WITNESSES)
3. COUNTY ROAD COMMISSION: WITNESS MAP, NO NAME OR DATE, RECITE SAME WITNESSES AS IN # 1 ABOVE
4. ALSO: ROAD PLANS FOR ASSYRIA HIGHWAY, NO NAME, 1964 "P.I. #2-STA 53+91 IRON ROD" STEEL ANC. POST S 33.0' STEEL ANC. POST NE 45.28' RD. NAME POST NW 41.50'

*** NO OTHER HISTORICAL INFORMATION, PUBLIC OR PRIVATE, AVAILABLE FOR THIS CORNER ***

B. Description of corner evidence found and/or method applied in restoring or reestablishing corner:

FOUND RAILROAD SPIKE ON PAINTED CENTERLINE EAST-WEST AT TOP OF GRAVEL SUB GRADE, UNDER BITUMINOUS ROAD. ALL WITNESSES IN PART "A" HAVE BEEN DESTROYED. DISTANCE TO FOUND RAILROAD SPIKE AT B-7 CONFIRMS STATIONING FROM ROAD COMMISSION.


ACCEPTED FOUND RAILROAD SPIKE AS BEST AVAILABLE EVIDENCE OF CORNER POSITION.

REPLACED FOUND RAILROAD SPIKE WITH STANDARD EATON COUNTY REMONUMENTATION MONUMENT.

C. Description of monument for corner and accessories established to perpetuate locating the position of the corner:

- SET STANDARD EATON COUNTY REMONUMENTATION MONUMENT (3/4" X 36" IRON) WITH PLASTIC CAP.
- SET 20d NAIL W/PLASTIC TAG IN THE SOUTH SIDE OF A UTILITY POLE S61°W 108.10'
- SET 20d NAIL W/PLASTIC TAG IN THE WEST SIDE OF A UTILITY POLE S04°W 54.53'
- SET 20d NAIL W/PLASTIC TAG IN THE SOUTH SIDE OF A WOODEN SPLIT RAIL FENCE POST N45°E 46.53'
- NORTHEAST CORNER CONCRETE FOUNDATION OF HOUSE #10995 S42°E 112.29'
- NORTHWEST CORNER CONCRETE FOUNDATION OF HOUSE #10995 S13°E 85.24'
- ON EAST-WEST PAINTED CENTERLINE (ASSYRIA HIGHWAY)
- 3'+/- WEST OF GRAVEL CENTERLINE NORTH (HILL ROAD)

P.A. 345 EATON COUNTY
PEER APPROVED 7/22/97 M

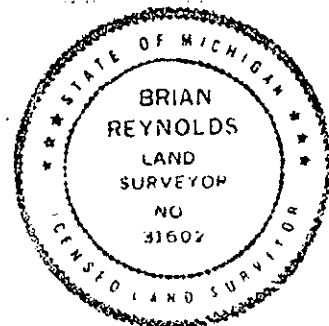

Signed by [Signature]
Surveyor's Michigan License No 31602

Date 8-15-97