

**SURVEY & REMONUMENTATION**

OCT 29 1993

**LAND CORNER RECORDATION CERTIFICATE**  
**Filing Requirement of Act 74, Mich. P.A. 1970**

*LIBER 3 PAGE 287*

**COMMISSION**  
 For corners in

|                                       |                         |               |
|---------------------------------------|-------------------------|---------------|
| <u>EATON</u><br>(County)              | Located In:             | Corner Code # |
| 1. Public Land Survey                 | T <u>2N</u> R <u>3W</u> | <u>B-11</u>   |
|                                       | T _____ R _____         | _____         |
|                                       | T _____ R _____         | _____         |
|                                       | T _____ R _____         | _____         |
| 2. Property Controlling in Section    | S _____ T _____ R _____ | _____         |
|                                       | S _____ T _____ R _____ | _____         |
| 3. Miscellaneous Property in Sec.     | S _____ T _____ R _____ | _____         |
|                                       | S _____ T _____ R _____ | _____         |
| 4. Lot No. _____, Recorded Plat _____ |                         |               |
| 5. Private Claims _____               |                         |               |

**FILED**  
 93 OCT 11 AM 11:42  
 REGISTER OF DEEDS  
 EATON COUNTY, MICH.

| A  | B  | C  | D  | E  | F  | G  | H | I | J | K | L |
|----|----|----|----|----|----|----|---|---|---|---|---|
| 2  | 6  | 5  | 4  | 3  | 2  | 1  |   |   |   |   |   |
| 3  |    |    |    |    |    |    |   |   |   |   |   |
| 4  | 7  | 8  | 9  | 10 | 11 | 12 |   |   |   |   |   |
| 5  |    |    |    |    |    |    |   |   |   |   |   |
| 6  | 18 | 17 | 16 | 15 | 14 | 13 |   |   |   |   |   |
| 7  |    |    |    |    |    |    |   |   |   |   |   |
| 8  | 19 | 20 | 21 | 22 | 23 | 24 |   |   |   |   |   |
| 9  |    |    |    |    |    |    |   |   |   |   |   |
| 10 | 30 | 29 | 28 | 27 | 26 | 25 |   |   |   |   |   |
| 11 |    |    |    |    |    |    |   |   |   |   |   |
| 12 | 31 | 32 | 33 | 34 | 35 | 36 |   |   |   |   |   |
| 13 |    |    |    |    |    |    |   |   |   |   |   |


I, RON HELSEL, in a field survey on AUG. 21, 19 93, do hereby certify that under requirements of P.A. 74, Michigan P.A. of 1970, the corner points mentioned in lines 1 and 2 above were in conformance with regulations and rules therefore as required in the current manual of survey instructions of the United States Department of the Interior, Bureau of Land Management or by a decree of a Court of Law and/or that the corner points mentioned in lines 3, 4 and 5 above were in conformance with the rules of the Michigan Board of Land Surveyors or by a Decree of a Court of Law; established, re-established, monumented, re-monumented, recovered, found as expressed below:

**NOTE: Not more than 4 corners, all in the same town and range, may be recorded on this certificate.**

A. Description of original monument and accessories and/or subsequent restoration:  
 ORIGINAL MONUMENT: POST SET BY HERVEY PARKE, U.S. DEPUTY SURVEYOR IN 1826.  
 BEARING TREES: BEECH 22, S71°E, 27 LINKS  
 BEECH 7, N73 1/2°W, 14 LINKS  
 FROM THE EATON COUNTY RECORD OF SURVEYS, VOLUME 2, PGS 88-89, M.H. BAILEY, COUNTY SURVEYOR, IN APRIL, 1879, FOUND THE POST AND SET A STONE.  
 BEARING TREES: W. ASH 14, S52 1/4°W, 80 LINKS  
 ELM 14, N71 3/4°E, 97 LINKS  
 A C.R.C. WAS RECORDED IN LIBER 1, PG 108 AND FIELD DATED DEC. 17, 1971 BY R.M. LESTER #18998. HE SET A 1/2" BAR ON LINE BETWEEN (A-11) & (C-11) OPPOSITE A FENCE TO THE NORTH.  
 (CONTINUED ON BACK)

B. Description of corner evidence found and/or method applied in restoring or reestablishing corner:  
 FOUND 3/4" PIPE & CAP #13039 (A.S. PIERSON).  
 FOUND WOOD ANCHOR POSTS SW & SE, AND A STEEL ANGLE IRON POST TO NORTH AS WITNESSED BY PIERSON. EXCAVATED A 12' x 12' HOLE 36" DEEP AROUND THE PIPE. FOUND NO EVIDENCE OF ORIGINAL CORNER OR STONE. ACCEPTED THE POSITION OF THE PIPE AS THE CORNER MARKER.  
 SET A 3/4" x 24" STEEL FORM PIN WITH A CAP LABELED P.A. 345 AT THE LOCATION OF THE PIPE AND WITNESSED. SET MON. BOX.

C. Description of monument for corner and accessories established to perpetuate locating the position of the corner:  
 STEEL FORM PIN IN MON. BOX 6.5' SOUTH E MILLS HWY & 7' WEST OF E OF BOSTEDOR ROAD, 5" BELOW SURFACE OF GRAVEL.  
 FOUND NAIL & TAG #17624 (G.D. LESTER) E/SIDE WOOD ANCHOR POST, S30°W, 47.04'  
 FOUND NAIL & TAG #11370 (R.S. STEADMAN) N/SIDE WOOD ANCHOR POST, S64°W, 43.84'  
 SE CORNER OF STEEL ANGLE IRON FENCE POST, N02°E, 29.71'  
 SET GALV. NAIL & TAG #18994 W/SIDE TWIN 10" ELM, N19°E, 36.38'

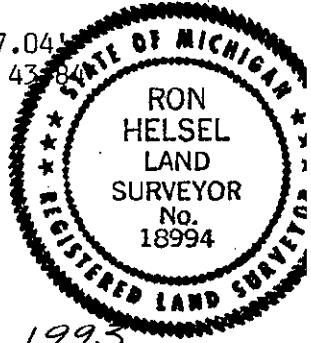

Signed by Ron Helsel Date Sept. 28, 1993  
 Surveyor's Michigan License No. 18994

P.A. 345 EATON COUNTY  
 PEER APPROVED 9/15/93 RL

*11-5-93*

"A" CONTINUED

WITNESSED AS:

NAIL & TAG S/SIDE 24" HICKORY ENE, 243.40'  
NAIL & TAG SE/SIDE 12" FENCE POST, SW, 47.04'  
SE CORNER OF IRON FENCE POST, NORTH, 29.70'

THIS CORNER WAS ESTABLISHED TO DETERMINE THE N-S 1/4 LINE OF SECTION 30 OF A SURVEY BY R.M. LESTER, RECORDED IN LIBER 1, PGS 114 & 115 AND FIELD DATED 12-14 (CIRCA 1971).

A C.R.C. WAS RECORDED IN LIBER 2, PG. 656 AND DATED 5-30-79 BY A.S. PIERSON #13039. PIERSON, "EXCAVATED TO VERIFY 1/2" ROD FOUND AT ROAD INTERSECTION, FOUND "NO OTHER" EVIDENCE AND ACCEPTED 1/2" IRON FOUND." WITNESSED AS:

12" FENCE POST, S67°W, 43.85'  
1 1/2" STEEL POST, N22°E, 37.95'  
12" FENCE POST, S35°W, 47.04'  
SE COR STEEL FENCE POST, N3°E, 29.70'

A SURVEY WAS RECORDED IN LIBER 2, PG 944 AND DATED 5-30-93 BY A.S. PIERSON, WITH IDENTICAL WITNESSES.

A SURVEY WAS RECORDED IN LIBER 5, PGS 240-241 AND DATED OCT. 9, 1990 BY R. HELSEL #18994. WITNESSES WERE THE SAME AS PIERSON'S AS RECORDED IN LIBER 2, PG 656.

DID NOT FIND ANY FURTHER MENTION OF THIS CORNER IN PUBLIC RECORDS.