

**SURVEY &
REMONUMENTATION**

OCT 29 1993

LAND CORNER RECORDATION CERTIFICATE
Filing Requirement of Act 74, Mich. P.A. 1970

LIBER 3 PAGE 279

For corners in **COMMISSION**
EATON
(County)

Located In: Corner Code --#

FILED

- | | | | | | |
|------------------------------------|---|-----------|---|-----------|------------|
| 1. Public Land Survey | T | <u>2N</u> | R | <u>3W</u> | <u>C-9</u> |
| | T | | R | | |
| | T | | R | | |
| | T | | R | | |
| 2. Property Controlling in Section | S | | T | R | |
| | S | | T | R | |
| 3. Miscellaneous Property in Sec. | S | | T | R | |
| | S | | T | R | |

93 OCT 11 AM 11:40

LINDA M. TWITCHELL
REGISTER OF DEEDS
Register of Deeds Stamp & File Number

4. Lot No. _____, Recorded Plat _____
5. Private Claims _____

I, RON HELSEL, in a field survey on AUG. 21, 19 93, do hereby certify that under requirements of P.A. 74, Michigan P.A. of 1970, the corner points mentioned in lines 1 and 2 above were in conformance with regulations and rules therefore as required in the current manual of survey instructions of the United States Department of the Interior, Bureau of Land Management or by a decree of a Court of Law and/or that the corner points mentioned in lines 3, 4 and 5 above were in conformance with the rules of the Michigan Board of Land Surveyors or by a Decree of a Court of Law; established, re-established, monumented, re-monumented, recovered, found as expressed below:

A	B	C	D	E	F	G	H	I	J	K	L	M
2	6		5		4		3		2		1	
3												
4	7		8		9		10		11		12	
5												
6	18		17		16		15		14		13	
7												
8	19		20		21		22		23		24	
9												
10	30		29		28		27		26		25	
11												
12	31		32		33		34		35		36	
13												

NOTE: Not more than 4 corners, all in the same town and range, may be recorded on this certificate.

A. Description of original monument and accessories and/or subsequent restoration:


ORIGINAL MONUMENT: POST SET BY HARVEY PARKE U.S. DEPUTY SURVEYOR IN 1826 WITH BEARING TREES: ELM 18, N73°W, 20 LINKS; BEECH 6 S41½°E, 13½ LINKS. DID NOT FIND ANY COUNTY SURVEY RECORDS OR SUBSEQUENT COUNTY ROAD OR CONSUMERS POWER RECORDS FOR THIS CORNER. G.D. LESTER RECORDED THIS CORNER IN LIBER 1, PG. 13 OF EATON CO. RECORDS FROM A SURVEY DATED AUGUST 10, 1971. HE SET A T-BAR & CAP #17624 IN THE INTERSECTION OF LONG HWY & CANFIELD RD BY USING PROPORTIONAL MEASUREMENTS FROM ALL CARDINAL DIRECTIONS FROM FENCE LINES & FOUND CORNERS. WITNESSED AS:
NAIL & TAG S/SIDE POWER POLE, ENE, 29.06'
NAIL & TAG N/SIDE 36" MAPLE, ESE, 38.65'
NAIL & TAG S/SIDE WALNUT, WNW, 68.18'

B. Description of corner evidence found and/or method applied in restoring or reestablishing corner:

FOUND THE "T"-BAR WITH THE 36" MAPLE ESE, AS THE ONLY REMAINING WITNESS. EXCAVATED A 10' x 14' HOLE 30" DEEP IN VICINITY OF INTERSECTION & AN EXISTING FENCE TO THE EAST. FOUND A LARGE FLAT BOULDER OPPOSITE THE MENTIONED FENCE. FOUND MANY STONES BUT NO BRICKS, CROCKERY OR WOOD. BOULDER WAS ESTIMATED TO WEIGH 500 LBS AND WAS DISMISSED AS BEING A CORNER MARKER. ACCEPTED THE T-BAR AS THE CORNER & WITNESSED. SET A 3/4" x 24" FORM PIN WITH A CAP LABELED P.A. 345 AND MONUMENT BOX AT THE POSITION OF THE T-BAR.

C. Description of monument for corner and accessories established to perpetuate locating the position of the corner:

STEEL FORM PIN 5" BELOW GRAVEL SURFACE 3' EAST E CANFIELD RD & 7' NORTH OF E LONG HWY & FENCE LINE TO EAST.
SET GALV. NAIL & TAG #18994 N/SIDE 40" MAPLE, S83°E, 38.43'
SET GALV. NAIL & TAG #18994 NW/SIDE 12" MAPLE, N37°E, 66.77'
SET GALV. NAIL & TAG #18994 W/SIDE 48" MAPLE, N12°E, 112.57'
SET GALV. NAIL & TAG #18994 NE/SIDE TWIN 12" BOXELDER, N60°W, 64.74'

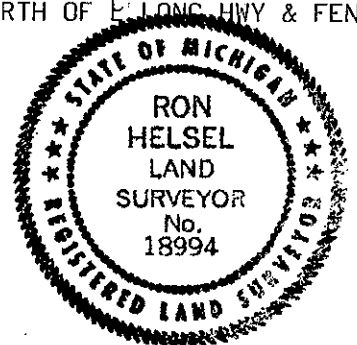

Signed by Ron Helsel Date Sept. 17, 1993
Surveyor's Michigan License No. 18994

P.A. 345 EATON COUNTY
PEER APPROVED 9/15/93 m

11-5-93