

OCT 29 1993

COMMISSION LAND CORNER RECORDATION CERTIFICATE Filing Requirement of Act 74, Mich. P.A. 1970

LIBER 3 PAGE 291

For corners in

Form with fields for EATON (County), Located In, Corner Code #, and numbered sections 1-5 for Public Land Survey, Property Controlling, Miscellaneous, Lot No., and Private Claims.

FILED stamp, date stamp 93 OCT 11 AM 11:42, and Register of Deeds Stamp & File Number stamp.

I, RON HELSEL, in a field survey on AUG. 13 & 21, 1993, do hereby certify that under requirements of P.A. 74, Michigan P.A. of 1970, the corner points mentioned in lines 1 and 2 above were in conformance with regulations and rules thereore as required in the current manual of survey instructions of the United States Department of the Interior, Bureau of Land Management or by a decree of a Court of Law and/or that the corner points mentioned in lines 3, 4 and 5 above were in conformance with the rules of the Michigan Board of Land Surveyors or by a Decree of a Court of Law; established, re-established, monumented, re-monumented, recovered, found as expressed below:


Grid table with columns A-L and rows 2-13, containing numbers 1-36.

NOTE: Not more than 4 corners, all in the same town and range, may be recorded on this certificate.

A. Description of original monument and accessories and/or subsequent restoration: ORIGINAL MONUMENT: POST SET BY U.S. DEPUTY SURVEYOR HARVEY PARK IN 1826. BEARING TREES: LYNN 24 N18°W, 49 LINKS; BEECH 8, S3 1/2°W, 12 LINKS FROM EATON COUNTY RECORDS "RECORD OF SURVEYS", VOLUME 2, PAGES 88-89, MH. BAILEY, CO. SURVEYOR, ON APRIL 17, 1879 DID NOT IDENTIFY THE CORNER BUT USED A BEARING TREE OF SUGAR 6, S88°W, 36 LINKS, K.D. FLUKE RLS #18988 FIELD DATED JANUARY 15, 1973, AS RECORDED IN LIBER 1, PAGE 254, CRC'S; FOUND A RAILROAD SPIKE AND WITNESSED: N85°W, 69.38', POWER POLE S50°W, 46.16', ELM, 3" DUE EAST, 26.89', POST (R/R TIE) (CONTINUED ON BACK)

B. Description of corner evidence found and/or method applied in restoring or reestablishing corner: FOUND RAILROAD SPIKE AND ALL (3) WITNESSES. EXCAVATED A 10' x 9' HOLE 36-42" DEEP OPPOSITE FENCE TO EAST AND AROUND VICINITY OF SPIKE. GRAVEL WAS 10" DEEP WITH A 1"± LAYER OF BLACK TOP SOIL UNDERNEATH WITH CLAY AND SAND BELOW. DID NOT FIND ANY EVIDENCE OF A POSSIBLE CORNER. ACCEPTED R.R. SPIKE & SET 3/4" x 24" FORM PIN WITH CAP LABELED P.A. 345; PIN 3' WEST OF CANFIELD ROAD AND 5'± SOUTH OF A TREE LINE WEST, ON LINE WITH FENCE TO EAST AND 5" BELOW GRAVEL SURFACE. SET MONUMENT BOX AND WITNESSED.

C. Description of monument for corner and accessories established to perpetuate locating the position of the corner: 3/4" x 24" FORM PIN IN MON. BOX FOUND DOUBLE HEAD NAIL & METAL TAG, (NO ID) NORTH/SIDE POWER POLE, N79°W, 69.31' S89°E, 26.8' FOUND DOUBLE HEAD N & METAL TAG, (NO ID) SOUTH/SIDE R.R. TIE ANCHOR POST, SET GALV. NAIL & TAG #18994 NORTH/SIDE 16" ELM, S47°W, 45.80' SET GALV. NAIL & TAG #18994 NE/SIDE 8" HICKORY, N55°E, 29.70'

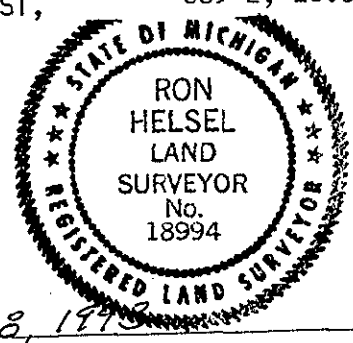

Signed by Ron Helsel Date Sept. 28, 1993 Surveyor's Michigan License No. 18994

P.A. 345 EATON COUNTY PEER APPROVED 9/15/93 RL

11-5-93

"A" CONTINUED

A SURVEY WAS RECORDED IN LIBER 1, PG. 281, DATED JAN. 15, 1973 BY K.D. FLUKE #18988. WITNESSES WERE THE SAME AS HIS C.R.C.

DID NOT FIND ANY FURTHER MENTION OF THIS CORNER IN PUBLIC RECORDS.

