

**SURVEY &
REMONUMENTATION**

OCT 29 1993

COMMISSION

LAND CORNER RECORDATION CERTIFICATE
Filing Requirement of Act 74, Mich. P.A. 1970

93 OCT 20 AM 10:42

FILED
copy

For corners in

<u>EATON</u> (County)	Located In:	Corner Code #
1. Public Land Survey	T <u>2N</u> R <u>3W</u>	<u>C-12</u>
	T _____ R _____	_____
	T _____ R _____	_____
	T _____ R _____	_____
2. Property Controlling in Section	S _____ T _____ R _____	_____
	S _____ T _____ R _____	_____
3. Miscellaneous Property in Sec.	S _____ T _____ R _____	_____
	S _____ T _____ R _____	_____
4. Lot No. _____, Recorded Plat _____		
5. Private Claims _____		

LINDA M. TWITCHELL
REGISTER OF DEEDS
EATON COUNTY, MICH.

LIBER 3 PAGE 297

Register of Deeds Stamp & File Number

I, RON HELSEL, in a field survey on AUG. 23, 19 93, do hereby certify that under requirements of P.A. 74, Michigan P.A. of 1970, the corner points mentioned in lines 1 and 2 above were in conformance with regulations and rules therefore as required in the current manual of survey instructions of the United States Department of the Interior, Bureau of Land Management or by a decree of a Court of Law and/or that the corner points mentioned in lines 3, 4 and 5 above were in conformance with the rules of the Michigan Board of Land Surveyors or by a Decree of a Court of Law, established, re-established, monumented, re-monumented, recovered, found as expressed below:

	A	B	C	D	E	F	G	H	I	J	K	L
2	6	5	4	3	2	1						
3												
4	7	8	9	10	11	12						
5												
6	18	17	16	15	14	13						
7												
8	19	20	21	22	23	24						
9												
10	30	29	28	27	26	25						
11												
12	31	32	33	34	35	36						
13												

NOTE: Not more than 4 corners, all in the same town and range, may be recorded on this certificate.

A. Description of original monument and accessories and/or subsequent restoration:

ORIGINAL MONUMENT: POST SET BY HERVEY PARKE, U.S. DEPUTY SURVEYOR, IN 1826.
BEARING TREES: 12" ELM, N75°E, 12 1/2 LINKS
6" B. ASH, S4 1/2°W, 24 LINKS

A C.R.C. WAS RECORDED IN LIBER 2, PG 454 AND FIELD DATED MAY 3, 1977 BY F.N. WHITE #12034, TOGETHER WITH A SURVEY DATED MAY 5, 1977 AND RECORDED IN LIBER 2, PG 343 OF SURVEYS.


(CONTINUED ON BACK)

B. Description of corner evidence found and/or method applied in restoring or reestablishing corner:

FOUND T-BAR AND CHERRY TREE TO SOUTH ALONG WITH A POWER POLE TO THE NW. EXCAVATED A 10' x 12' HOLE AROUND THE BAR. AT 12" DEEP FOUND 22" x 3/4" BARN BEAM DRILL BIT UNDER THE T-BAR. BELOW THE BARN BIT, AT 30", FOUND A LARGE POINTED STONE NEXT TO A PHONE CABLE. ACCEPTED THE DRILL BIT AS THE LOCATION OF THE CORNER MARKER AND RAISED TO GRADE. CORNER 2' EAST OF EDGE OF GRAVEL ROAD, 14.5' OFF CENTERLINE OF ROAD, 2' NORTH OF AN OVERHEAD POWER LINE AND ON LINE WITH A FENCE TO THE EAST.

C. Description of monument for corner and accessories established to perpetuate locating the position of the corner:

3/4" x 22" BARN BEAM DRILL BIT.
SET GALV. NAIL & TAG #18994 S/SIDE WOOD ANCHOR POST, S89°W, 33.72'
SET GALV. NAIL & TAG #18994 N/SIDE TWIN 14" OAK, S53°W, 70.26'
SET GALV. NAIL & TAG #18994 W/SIDE TRIPLE 16" CHERRY, S02°W, 36.94'
FOUND NAIL & METAL TAG #16053 (J.E. STEPHENS) E/SIDE UTILITY POLE, N24°W, 51.30'

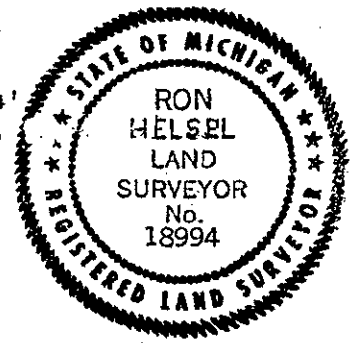

Signed by Ron Helsel Date Sept. 28, 1993
Surveyor's Michigan License No. 18994

FORM APPROVED BY MICHIGAN STATE BOARD OF LAND SURVEYORS, JAN. 28, REVISED MAY 14, REVISED JAN.,

P.A. 345 EATON COUNTY
PEER APPROVED 9/29/93

11-5-93

2017/2018

"A" CONTINUED

WITNESSED AS:

T-IRON AT PI OF ROAD

FOUND NAIL & TAG IN WEST SIDE TWIN 10" CHERRY TREE, SOUTH, 37.27'

FOUND NAIL & TAG IN WEST SIDE POWER POLE, N15°E, 60.88'

FOUND NAIL & TAG IN WEST SIDE POWER POLE, N15°W, 51.30'

DID NOT FIND ANY FURTHER MENTION OF THIS CORNER IN PUBLIC RECORDS.

