

**SURVEY & REMONUMENTATION**

OCT 29 1993

**COMMISSION**

**LAND CORNER RECORDATION CERTIFICATE**  
**Filing Requirement of Act 74, Mich. P.A. 1970**

LIBER 3 PAGE 280

**FILED**

For corners in  
EATON  
 (County)

Located In:

Corner Code #/

- |                                    |   |    |   |    |      |
|------------------------------------|---|----|---|----|------|
| 1. Public Land Survey              | T | 2N | R | 3W | C-13 |
|                                    | T |    | R |    |      |
|                                    | T |    | R |    |      |
|                                    | T |    | R |    |      |
| 2. Property Controlling in Section | S |    | T | R  |      |
|                                    | S |    | T | R  |      |
| 3. Miscellaneous Property in Sec.  | S |    | T | R  |      |
|                                    | S |    | T | R  |      |
4. Lot No. \_\_\_\_\_, Recorded Plat \_\_\_\_\_
5. Private Claims \_\_\_\_\_

93 OCT 11 AM 11:40

LINDA M. TWITCHELL  
 REGISTER OF DEEDS  
 EATON COUNTY, MICH.

Register of Deeds Stamp & File Number


	A	B	C	D	E	F	G	H	I	J	K	L	M
2	6	5	4	3	2	1							
3													
4	7	8	9	10	11	12							
5													
6	18	17	16	15	14	13							
7													
8	19	20	21	22	23	24							
9													
10	30	29	28	27	26	25							
11													
12	31	32	33	34	35	36							
13													

I, RON HELSEL, in a field survey on AUG. 13 & 21, 19 93, do hereby certify that under requirements of P.A. 74, Michigan P.A. of 1970, the corner points mentioned in lines 1 and 2 above were in conformance with regulations and rules therefore as required in the current manual of survey instructions of the United States Department of the Interior, Bureau of Land Management or by a decree of a Court of Law and/or that the corner points mentioned in lines 3, 4 and 5 above were in conformance with the rules of the Michigan Board of Land Surveyors or by a Decree of a Court of Law; established, re-established, monumented, re-monumented, recovered, found as expressed below:

**NOTE: Not more than 4 corners, all in the same town and range, may be recorded on this certificate.**

- A. Description of original monument and accessories and/or subsequent restoration:  
 ORIGINAL MONUMENT: POST SET BY HARVEY PARK U.S. DEPUTY SURVEYOR IN 1826. BEARING TREES: W. OAK 30, N40°W, 16 LINKS, W. OAK 30, N52°E, 62 LINKS. IN THE MARGIN OF THE G.L.O. NOTES AT EATON CO. REG. OF DEEDS CALLS FOR A STONE BUT NO WITNESSES. DID NOT FIND ANY FURTHER MENTION OF THIS CORNER IN PUBLIC RECORDS. THE G.L.O. SURVEY OF HAMLIN TWP NOTES INDICATES THAT THIS CORNER IS 86 LINKS WEST OF THE CORNER COMMON TO SECTIONS 5 & 6 OF HAMLIN TWP.
- B. Description of corner evidence found and/or method applied in restoring or reestablishing corner:  
 FOUND A BAR & CAP SET BY P.S. K.D. FLUKE #18988 IN A SURVEY OF SEC. 6, HAMLIN TWP., JAN. 19, 1992. FOUND A 3/4" PINCH PIPE AT THE CORNER COMMON TO SEC. 6 & SEC 5 OF HAMLIN TWP. MEASURED 56.77' BETWEEN IRONS (G.L.O. 86 LINKS). WE WERE DENIED ACCESS TO HAND EXCAVATE AROUND THE FLUKE BAR & CAP TO VERIFY ITS LOCATION BY THE PROPERTY OWNERS TO THE NORTH. EXCAVATED A 6' x 8' HOLE AT THE PIPE TO THE EAST & FOUND A 24" x 4" x 6" CHISLED & SHAPED STONE LYING IN A FLAT PRONE POSITION ON THE SOUTH SIDE AND NEXT TO THE PINCH PIPE. FURTHER EXCAVATION DID NOT LOCATE ANY SUPPORTING EVIDENCE OF THE EXACT LOCATION OF THE STONES ORIGINAL POSITION. ACCEPTED THE PIPE AS THE CORNER FOR SEC. 5 & 6 OF HAMLIN TWP & REPLACED WITH 3/4" x 24" FORM PIN WITH CAP LABELED P.A. 345 AND TRAVERSED FROM THE PIPE TO THE SW COR OF SEC 31 AND DETERMINED THAT FLUKE'S BAR & CAP WAS SET ON LINE BETWEEN THESE CORNERS AT THE G.L.O. FALLING DISTANCE OF 86 LINKS. ACCEPTED FLUKE'S BAR & CAP AS THE CORNER AND WITNESSED.
- C. Description of monument for corner and accessories established to perpetuate locating the position of the corner:  
 1/2" BAR & CAP #18988 35'± WEST OF THE PHYSICAL [ ] OF CANFIELD ROAD.  
 FOUND NAIL & TAG #18988 N/SIDE 22" TWIN HICKORY, S89°E, 20.65'  
 FOUND NAIL & TAG #18988 E/SIDE 18" HICKORY, N22°E, 25.97'  
 FOUND NAIL & TAG #18988 S/SIDE 16" ASH, S50°E, 7.18'  
 FOUND NAIL & TAG #18988 S/SIDE 12" ELM, N64°W, 23.46'  
 EAST 56.77' FD. STONE & PIPE. (REPLACED WITH 3/4" FORM PIN & CAP, P.A. 345)

Signed by Ron Helsel Date Sept 17 1993  
 Surveyor's Michigan License No. 18994

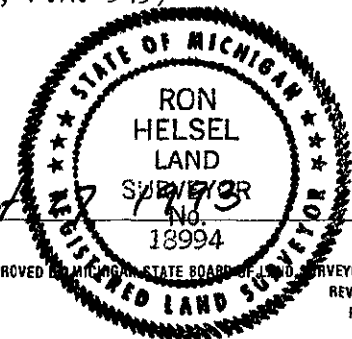

FORM APPROVED BY MICHIGAN STATE BOARD OF LAND SURVEYORS, JAN. 28, 1971  
 REVISED MAY 14, 1975  
 REVISED JAN., 1983

P.A. 345 EATON COUNTY  
 PEER APPROVED 9/15/93 RL

11-5-93