

DEC 1 2 1997

COMMISSION

LAND CORNER RECORDATION CERTIFICATE
Filing Requirement of Act 74, Mich. P.A. 1970

For corners in
EATON RAPIDS TOWNSHIP
EATON COUNTY

Located in: Corner Code #

1. Public Land Survey	T <u>2N</u> R <u>3W</u>	<u>M-9</u>
	T _____ R _____	_____
	T _____ R _____	_____
	T _____ R _____	_____
2. Property Controlling in Section	S _____ T _____ R _____	_____
	S _____ T _____ R _____	_____
3. Miscellaneous Property in Sec.	S _____ T _____ R _____	_____
	S _____ T _____ R _____	_____

FILED

copy

97 DEC -2 AM 10: 07

LINDA M. TWITCHELL
REGISTER OF DEEDS
EATON COUNTY, MICH.

LIBER

3 PAGE 862

Register of Deeds Stamp & File Number

4. Lot No. _____, Recorded Plat _____
5. Private Claims _____

I, Maurice H. Mahieu, in a field survey on October 29, 1997 do hereby state that under requirements of P.A. 74, Michigan P.A. of 1970, the corner points mentioned in lines 1 and 2 above were in conformance with regulations and rules therefore as required in the current manual of survey instructions of the United States Department of the Interior, Bureau of Land Management or by a decree of a Court of Law and /or that the corner points mentioned in lines 3, 4 and 5 above were in conformance with the rules of the Michigan Board of Land Surveyors or by a Decree of a Court of Law; established, re-established, monumented, recovered, found as expressed below:

NOTE: Not more than 2 corners, all in the same town and range, may be recorded on this certificate.

A	B	C	D	E	F	G	H	I	J	K	L
1											
2	6		5		4		3		2		1
3											
4	7		8		9		10		11		12
5											
6	18		17		16		15		14		13
7											
8	19		20		21		22		23		24
9											
10	30		29		28		27		26		25
11											
12	31		32		33		34		35		36
13											

A. Description of original monument and accessories and/or subsequent restoration:

1. The Original GLO corner was set by Harvey Parke, D.S. in 1826; witnessed by Beech 5 S29 1/2W 04; DO 10 N40W 63. GLO falling is 75 lks (49.5') to A-9 Aurelius Township.
2. Side note on Eaton County Road Commission copy of Original GLO field notes states a "Stone".
3. Eaton County Surveyors Records, Vol. 1, Page 57: J.H. Gibbons dated 1869 notes corner to be a stone and dishes witnessed by a 6" Maple bearing N.E. 46.3 ft. and a 20" Hickory bearing S.E. 61.6 ft.
4. Ingham County Road Commission records call for a pointed stone and crockery with a well point to the surface witnessed by a 24" Maple bearing N.E. 46.3 ft. and a 20" Hickory bearing S.E. 61.6 ft.
5. Eaton County Road Commission records call for a well point witnessed by a 24" Maple bearing N.E. 46.3 ft. and a 20" Hickory bearing S.E. 61.6 feet.

(Continued On Back)

B. Description of corner evidence found and/or method applied in restoring or reestablishing corner:


Found 3/4" pipe with cap #11370 in monument box in the centerline of Waverly and Toles Road (west). Found Nail and Tag in Power Pole (Steadman) S 53° W 59.99'. Did not excavate corner due to previous excavation by Steadman. Steadman's digging found the perpetuated position of the corner which this surveyor agrees. Traverse East section line and measured 2658.70 to M-10, 2660.32 to M-8.

C. Description of monument for corner and accessories established to perpetuate locating the position of the corner:

Found 3/4" Pipe with cap #11370 in Monument box witnessed by:
Found Nail Northwest side 30" Maple N 41° E 46.21'
Set Nail and Tag #28414 North side 24' Hickory S 65° E 60.92'
Found Nail & Tag #11370 Southeast side Power Pole S 53° W 59.99'
Set Nail & Tag #28414 North side 21" Maple N 65° W 79.95'
A-9 of T2N, R2W, Aurelius Township, South 49.80'
GLO Falling is 75 lks (49.5') to A-9, Aurelius Township

Signed by Maurice H. Mahieu
Surveyor's Michigan License No. 28414

Date 11-25-97

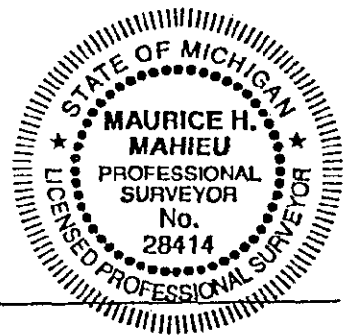

P.A. 345 EATON COUNTY
PEER APPROVED 10/30/97

M-9 (Continued)

6. A LCRC recorded in Liber 1, Page 382 dated Feb. 5, 1974 by Richard W. Steadman, P.S. #11370: "Dug hole and found pointed stone with broken china and stones around and a well point on west side. Removed well point and raised location of stone to surface of Waverly Road with 3/4" pipe and cap. Witnessed by:
P.K. Nail in 26" Maple N.E. 46.24 ft.
Nail and Tag in 22" Hickory S.E. 61.52 ft.
Nail and Tag in 14" Elm N.W. 81.51 ft.
Nail and Tag in Power Pole S.W. 59.98 ft.
Corner common to Section 19 and 30, T2N, R3W (3/4" iron pipe and cap over stone) is South 49.76 feet."
7. An Act 132 survey by Ronnie Lester, P.S. #18998 recorded in Liber 1, Page 924 on Aug. 25, 1975 calls for, "1/2" bar in monument box as recorded". Measured 2660.27 to M-9.
8. An Act 132 survey by Richard W. Steadman P.S. #11370 recorded in Liber 3, Page 107 on Feb. 2, 1980 calls for corner and witnesses same as A-6.