

DEC 1 8 1997

97 NOV 24 AM 10: 27

COMMISSION

LAND CORNER RECORDATION CERTIFICATE
Filing Requirement of Act 74, Mich. P.A. 1970

For corners in

| | | |
|------------------------------------|-------------------------|---------------|
| <u>EATON COUNTY</u> (County) | Located In: | Corner Code # |
| EATON TOWNSHIP | T <u>2N</u> R <u>4W</u> | <u>A-11</u> |
| 1. Public Land Survey | T _____ R _____ | _____ |
| | T _____ R _____ | _____ |
| 2. Property Controlling in Section | S _____ T _____ R _____ | _____ |
| | S _____ T _____ R _____ | _____ |
| 3. Miscellaneous Property in Sec. | S _____ T _____ R _____ | _____ |
| | S _____ T _____ R _____ | _____ |

LINDA M. TWITCHELL
REGISTER OF DEEDS
EATON COUNTY, MICH.

Copy
Liber 3 pg 843

Register of Deeds Stamp & File Number

4. Lot No. _____, Recorded Plat _____
5. Private Claims _____

I, DAVID L. CLIFFORD, in a field survey on JULY 31, 1997 do hereby state that under requirements of P.A. 74, Michigan P.A. of 1970, the corner points mentioned in lines 1 and 2 above were in conformance with regulations and rules therefore as required in the current manual of survey instructions of the United States Department of the Interior, Bureau of Land Management or by a decree of a Court of Law and /or that the corner points mentioned in lines 3, 4 and 5 above were in conformance with the rules of the Michigan Board of Land Surveyors or by a Decree of a Court of Law; established, re-established, monumented, recovered, found as expressed below:

NOTE: Not more than 2 corners, all in the same town and range, may be recorded on this certificate.

| | | | | | | | | | | | | | |
|----|----|---|----|---|----|---|----|---|----|---|----|---|---|
| | A | B | C | D | E | F | G | H | I | J | K | L | M |
| 1 | | | | | | | | | | | | | |
| 2 | 6 | | 5 | | 4 | | 3 | | 2 | | 1 | | |
| 3 | | | | | | | | | | | | | |
| 4 | 7 | | 8 | | 9 | | 10 | | 11 | | 12 | | |
| 5 | | | | | | | | | | | | | |
| 6 | 10 | | 17 | | 16 | | 15 | | 14 | | 13 | | |
| 7 | | | | | | | | | | | | | |
| 8 | 19 | | 20 | | 21 | | 22 | | 23 | | 24 | | |
| 9 | | | | | | | | | | | | | |
| 10 | 30 | | 29 | | 28 | | 27 | | 26 | | 25 | | |
| 11 | | | | | | | | | | | | | |
| 12 | 31 | | 32 | | 33 | | 34 | | 35 | | 36 | | |
| 13 | | | | | | | | | | | | | |

A. Description of original monument and accessories and/or subsequent restoration:


1. JOHN MULLET D.S. SET POST FOR M-11, T2N, R5W IN NOVEMBER 1824; BEECH 8" N62°W 31 LKS, SUGAR 8" S38½°W 30 LKS.
2. SYLVESTER SIBLEY, D.S. MARKED A 15" BEECH FOR CORNER, 70 LKS. (46.2') SOUTH OF M-11, T2N, R5W IN NOVEMBER 1825.
3. M.H. BAILEY, COUNTY SURVEYOR, CALLED FOR A STONE & CROCKERY AT CORNER IN A SURVEY RECORDED IN BOOK 1 PAGE 15 IN MAY 1868.
4. MARGINAL NOTE IN THE EATON COUNTY ROAD COMMISSION COPY OF THE GLO NOTES: SEC. COR. 30-31 STONE "+"; ELECTRIC POWER POLE N46E 45½', 12" S. MAPLE N33½W 94', 8" MAPLE N72W 44½'
5. JIM STEPHENS RLS #16053 RECORDED CORNER IN LIBER 1 PAGE 349 IN NOVEMBER 1973 AS A FOUND RAILROAD SPIKE 3.17' WEST OF CENTERLINE COCHRAN ROAD: SURVEY TAG IN NW SIDE UTILITY POLE, N57°E, 61.33'; SURVEY TAG IN NORTH SIDE UTILITY POLE, S64°E, 66.84'; SURVEY TAG IN S. SIDE UTILITY POLE, N67°W, 44.38'
6. LARRY CHRISTENSON LS #30890 RECORDED CORNER IN LIBER 3 PAGE 256 IN MARCH 1995 AS A FOUND RAILROAD SPIKE 3.17' WEST OF CENTERLINE COCHRAN ROAD FROM 1 REMAINING WITNESS OF LCRC RECORDED IN LIBER 1 PAGE 349; ESE, 66.91', N&T S. SIDE POLE; ENE, 62.93', ANGLE IRON FENCE CORN., NNW, 91.55', SE CORN. TOP CONC. RW.

B. Description of corner evidence found and/or method applied in restoring or reestablishing corner:

SEARCHED AT APPARENT LOCATION OF CORNER AND FOUND RAILROAD SPIKE 3.2 FEET WEST OF CENTERLINE COCHRAN ROAD AND 46.20' SOUTH OF M-11, T2N, R5W MATCHING ALL OF L. CHRISTENSONS WITNESSES. EXCAVATED 1.5' DIAMETER HOLE THROUGH 5" OF ASPHALT TO CONCRETE SURFACE BELOW. FOUND VERY OLD PIPE IN MONUMENT BOX IN CONCRETE SURFACE OF OLD ROAD. EXCAVATED THROUGH MONUMENT BOX & FOUND STONE DIRECTLY BENEATH PIPE & RAILROAD SPIKE. ACCEPTED STONE, PIPE & RAILROAD SPIKE AS PERPETUATION OF CORNER AND DRILLED HOLE IN STONE & SET STANDARD BAR & CAP IN IT. RAISED MONUMENT BOX TO SURFACE WITH 2 RINGS. MEASURED NORTH 2641.33' TO A-10. BRYAN LAND SURVEYS MEASURED SOUTH 2637.87' TO A-12 IN A SURVEY AT SAME TIME AS MY INVESTIGATION OF CORNER LOCATION.

C. Description of monument for corner and accessories established to perpetuate locating the position of the corner:

A-11 T2N, R4W
3/4" BAR & ORANGE PLASTIC CAP IMPRINTED PA 345 PS 25837 IN MONUMENT BOX 3.2' WEST OF CENTERLINE COCHRAN ROAD
3/4" BAR & CAP IN MONUMENT BOX (M-11, T2N, R5W), 0° NAZ, 46.20'
SET NAIL & TAG #28409 NORTH SIDE 44" MAPLE, 282° NAZ, 75.68'
SET NAIL & TAG #28409 SOUTH SIDE 37" MAPLE, 324° NAZ, 93.96'
FOUND NAIL & TAG #30890 SOUTH SIDE POWER POLE, 112° NAZ, 66.91'
FOUND NAIL & TAG #30890 EAST SIDE 30" MAPLE, 212° NAZ, 71.35'
NE CORNER FOUNDATION HOUSE, 252° NAZ, 94.96'
2" ANGLE IRON FENCE POST IN CONCRETE, 57° NAZ, 62.90'
SW CORNER CONCRETE ROW MARKER, 329°, 93.96'

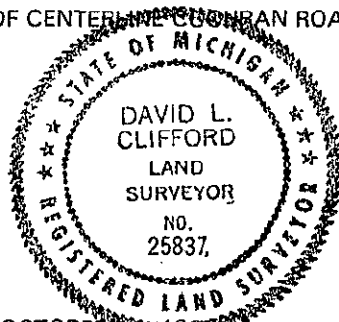

Signed by David L. Clifford

Date OCTOBER 19 1997

Surveyor's Michigan License No. 25837