

DEC 1 2 1997

COMMISSION

LAND CORNER RECORDATION CERTIFICATE  
Filing Requirement of Act 74, Mich. P.A. 1970

97 NOV 24 AM 10: 28

For corners in

<u>EATON COUNTY</u> (County)	Located In:	Corner Code
EATON TOWNSHIP	T <u>2N</u> R <u>4W</u>	<u>A-12</u>
1. Public Land Survey	T _____ R _____	_____
	T _____ R _____	_____
	T _____ R _____	_____
2. Property Controlling in Section	S _____ T _____ R _____	_____
	S _____ T _____ R _____	_____
3. Miscellaneous Property in Sec.	S _____ T _____ R _____	_____
	S _____ T _____ R _____	_____

LINDA M. TWITCHELL  
REGISTER OF DEEDS  
EATON COUNTY, MICH.

Copy

Liber 3 pg 844

Register of Deeds Stamp & File Number

4. Lot No. \_\_\_\_\_, Recorded Plat \_\_\_\_\_  
5. Private Claims \_\_\_\_\_

I, DAVID L. CLIFFORD, in a field survey on SEPTEMBER 30, 1997 do hereby state that under requirements of P.A. 74, Michigan P.A. of 1970, the corner points mentioned in lines 1 and 2 above were in conformance with regulations and rules therefore as required in the current manual of survey instructions of the United States Department of the Interior, Bureau of Land Management or by a decree of a Court of Law and /or that the corner points mentioned in lines 3, 4 and 5 above were in conformance with the rules of the Michigan Board of Land Surveyors or by a Decree of a Court of Law; established, re-established, monumented, recovered, found as expressed below:

NOTE: Not more than 2 corners, all in the same town and range, may be recorded on this certificate.

	A	B	C	D	E	F	G	H	I	J	K	L	M
1													
2	6		5		4		3		2		1		
3													
4	7		8		9		10		11		12		
5													
6	18		17		16		15		14		13		
7													
8	19		20		21		22		23		24		
9													
10	30		29		28		27		26		25		
11													
12	31		32		33		34		35		36		
13													

A. Description of original monument and accessories and/or subsequent restoration:

1. JOHN MULLET D.S. SET POST FOR M-12, T2N, R5W IN NOVEMBER 1824; BEECH 6" S29°W 28 LKS, DO 6" N58°W 14 LKS.
2. CORNER NOT SET IN GLO SURVEY
3. M.H. BAILEY, COUNTY SURVEYOR, ESTABLISHED CORNER IN A SURVEY RECORDED IN BOOK 1 PAGE 15 IN MAY 1868.
4. EATON COUNTY ROAD COMMISSION GRID MAP: 3/4" PIPE-MON. BOX; 11" MAPLE-NW-78.72"; T.P.-NW-44.13"; + IN STA. 18+00 RAMP STA. NE 86.76'.
5. ON MSHD FORM 280 DATED MARCH 1968 ARDEN PIERSON LS 13039 CALLED FOR CORNER WITH SAME MONUMENT & WITNESSES AS ITEM 4
6. JIM STEPHENS RLS #16053 RECORDED CORNER IN LIBER 1 PAGE 350 IN NOVEMBER 1973 AS A FOUND 1/2" IRON ROD IN MONUMENT BOX ON CENTERLINE COCHRAN ROAD: SURVEY TAG IN TOP GUARD RAIL POST, N51°E, 34.95'; NW CORNER OF A CONC. BRIDGE RAIL, S48°E, 34.10'; NE CORNER OF A CONC. BRIDGE RAIL, S19°W, 72.78'
7. LARRY BRYAN PLS #25832 USED CORNER IN AN ACT 132 SURVEY IN AUGUST 1997 AS A FOUND 1/2" BAR IN MONUMENT BOX 1.5' WEST OF CENTERLINE COCHRAN ROAD.

B. Description of corner evidence found and/or method applied in restoring or reestablishing corner:


SEARCHED AT APPARENT LOCATION OF CORNER AND FOUND 1/2" BAR IN MONUMENT BOX 1.5 FEET WEST OF CENTERLINE COCHRAN ROAD AND 20.06' SOUTH OF M-12, T2N, R5W MATCHING ALL OF J. STEPHENS WITNESSES. DID NOT EXCAVATE BECAUSE CORNER IS IN 30' OF FILL FOR I-69 OVERPASS. ACCEPTED BAR AS CORNER AS PERPETUATED BY THE HIGHWAY DEPARTMENT. BRYAN LAND SURVEYS GPS TRAVERSE OF SECTION 36, T2N R5W SHOW CORNER TO LIE 0.2 EAST OF STANDARD LINE. BRYAN LAND SURVEYS MEASURED NORTH 2637.87' TO A-11 AND SOUTH 2643.95.

C. Description of monument for corner and accessories established to perpetuate locating the position of the corner:

- A-12 T2N, R4W
- 1/2" BAR & ORANGE PLASTIC CAP IMPRINTED PA 345 PS 25837 IN MONUMENT BOX 1.5' WEST OF CENTERLINE COCHRAN ROAD
- 3/4" BAR & CAP ( M-12, T2N, R5W), 0° NAZ, 20.06'
- FOUND NAIL & TAG #16053 IN TOP GUARD RAIL POST, 50° NAZ, 35.07'
- FOUND NAIL & TAG #25832 IN TOP GUARD RAIL POST, 269° NAZ, 23.07'
- FOUND 60D SPIKE IN TOP GUARD RAIL POST, 96° NAZ, 26.97'
- NE CORNER BRIDGE ABUTMENT, 129° NAZ, 35.20'
- NW CORNER BRIDGE ABUTMENT, 199° NAZ, 72.83'

Signed by David L. Clifford  
Surveyor's Michigan License No. 25837

Date OCTOBER 11, 1997

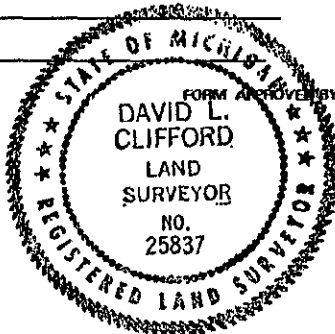

FORM APPROVED BY MICHIGAN STATE BOARD OF PROFESSIONAL SURVEYORS.  
JAN. 28, 1971  
REVISED MAY 14, 1975  
REVISED JAN., 1983  
REVISED OCT., 1995

P.A. 345 EATON COUNTY  
PEER APPROVED 10/14/97 M