

**SURVEY &
REMONUMENTATION**

OCT 18 1996

LAND CORNER RECORDATION CERTIFICATE

Filing Requirement of Act 74, Mich. P.A. 1970

EATON TOWNSHIP

96 JUN 11 AM 10:05

FILED
COPY

For corners in **COMMISSION**

EATON (County)	Located In:	Corner Code -##
1. Public Land Survey	T <u>2N</u> R <u>4W</u>	<u>L-12</u>
	T _____ R _____	_____
	T _____ R _____	_____
	T _____ R _____	_____
2. Property Controlling in Section	S _____ T _____ R _____	_____
	S _____ T _____ R _____	_____
3. Miscellaneous Property in Sec.	S _____ T _____ R _____	_____
	S _____ T _____ R _____	_____

LINDA M. TWITCHELL
REGISTER OF DEEDS
EATON COUNTY, MICH.

LIBER 3 Pg 682

Register of Deeds Stamp & File Number

4. Lot No. _____, Recorded Plat _____
5. Private Claims _____

	A	B	C	D	E	F	G	H	I	J	K	L	M
2	6	5	4	3	2	1							
3													
4	7	8	9	10	11	12							
5													
6	18	17	16	15	14	13							
7													
8	19	20	21	22	23	24							
9													
10	30	29	28	27	26	25							
11													
12	31	32	33	34	35	36							
13													


I, RON HELSEL, in a field survey on APRIL 24, 19 96, do hereby certify that under requirements of P.A. 74, Michigan P.A. of 1970, the corner points mentioned in lines 1 and 2 above were in conformance with regulations and rules therefore as required in the current manual of survey instructions of the United States Department of the Interior, Bureau of Land Management or by a decree of a Court of Law and/or that the corner points mentioned in lines 3, 4 and 5 above were in conformance with the rules of the Michigan Board of Land Surveyors or by a Decree of a Court of Law; established, re-established, monumented, re-monumented, recovered, found as expressed below:

NOTE: Not more than 4 corners, all in the same town and range, may be recorded on this certificate.

A. Description of original monument and accessories and/or subsequent restoration:
CORNER WAS NOT SET IN ORIGINAL GOVERNMENT SURVEY. DID NOT FIND ANY RECORDS OF COUNTY SURVEYOR ACTIVITY IN THIS SECTION NOR ANY PUBLIC OR PRIVATE SURVEYS.

B. Description of corner evidence found and/or method applied in restoring or reestablishing corner:
SEARCHED THE PROBABLE AREA AND FOUND AN OLD 3/4" X 24" PIPE ON TOP OF A 4" SQUARE POINTED BLUE STONE TAPERED TO 8", WRAPPED IN WIRE, AT THE SOUTHEASTERLY BASE OF AN OLD ROTTED WOOD ANCHOR POST. FENCES TO NORTH, EAST & WEST. STONE WAS ABOUT 10" DEEP AND SURROUNDED WITH OTHER STONES (TYPICAL FOR AN OLD ANCHOR POST LOCATION). TRAVERSE COMPUTATIONS SITUATED THE STONE 2.39', N36°E OF THE INTERSECTION OF THE EAST-WEST & NORTH-SOUTH 1/4 LINES. SINCE THE SOUTH 1/4 CORNER AND THE WEST 1/4 CORNER OF SECTION 36 HAVE BEEN DETERMINED AS "LOST" AND HAVE BEEN RE-ESTABLISHED ON THE MID POINTS OF THE SOUTH & WEST SECTION LINES PER THE STANDARD MANUAL OF PRACTICE, THE LOCATION OF THIS STONE WAS ACCEPTED. RESET THE PIPE WITH A CAP LABELED P.A. 345 P.S. NO. 18994. NOTE: THE 24" LONG STANDARD PIN WAS IMPOSSIBLE TO SET IN A SECURE POSITION BECAUSE OF ALL THE STONES, SOME TOO LARGE TO MOVE BY HAND. BELIEVE THIS CORNER REPRESENTS A PERPETUATION OF AN UNRECORDED COUNTY SURVEYOR SURVEY.

C. Description of monument for corner and accessories established to perpetuate locating the position of the corner:
3/4" PIPE AND CAP AT SE'LY SIDE OF 16" WOOD ANCHOR POST
SET NAIL & TAG #18994 W/SIDE 8" POPLAR AZ. 180°-30', 8.33'
SET NAIL & TAG #18994 N/SIDE 8" POPLAR AZ. 260°, 15.30'
SET NAIL & TAG #18994 E/SIDE 8" POPLAR AZ. 13°, 6.51'
SET NAIL & TAG #18994 S/SIDE 8" POPLAR AZ. 98°, 14.83'
WEST, 2649.40 FEET TO K-12 (WEST 1/4 COR.)
SOUTH, 2655.91 FEET TO L-13 (SOUTH 1/4 COR.)
NORTH, 2645.99 FEET TO L-11 (NORTH 1/4 COR.)
EAST, ±2643.8 FEET TO M-12 (EAST 1/4 COR.)

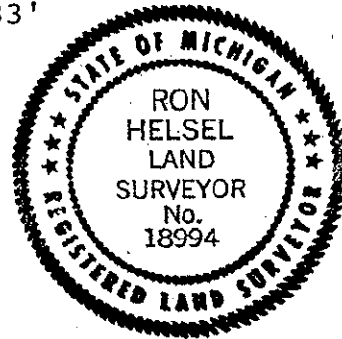

Signed by Ron Helsel Date APRIL 29, 1996
Surveyor's Michigan License No. 18994

P.A. 345 EATON COUNTY
PEER APPROVED 5/23/96 RL