

**SURVEY &
REMONUMENTATION**

APR 27 1995

COMMISSION

LAND CORNER RECORDATION CERTIFICATE
Filing Requirement of Act 74, Mich. P.A. 1970

FILED
Copy

94 AUG -2 PM 2: 34

For corners in

EATON

<u>EATON</u> (County)	Located In:	Corner Code #
	2N R 4W	L-13
1. Public Land Survey	T _____ R _____	_____
	T _____ R _____	_____
	T _____ R _____	_____
	T _____ R _____	_____
2. Property Controlling in Section	S _____ T _____ R _____	_____
	S _____ T _____ R _____	_____
3. Miscellaneous Property in Sec.	S _____ T _____ R _____	_____
	S _____ T _____ R _____	_____
4. Lot No. _____, Recorded Plat _____		
5. Private Claims _____		

LINDA M. TWITCHELL
REGISTER OF DEEDS
EATON COUNTY, MICH.

LIBER 3 PAGE 133

Register of Deeds Stamp & File Number

I, RON HELSEL, in a field survey on JUNE 6, 1994, do hereby certify that under requirements of P.A. 74, Michigan P.A. of 1970, the corner points mentioned in lines 1 and 2 above were in conformance with regulations and rules therefore as required in the current manual of survey instructions of the United States Department of the Interior, Bureau of Land Management or by a decree of a Court of Law and/or that the corner points mentioned in lines 3, 4 and 5 above were in conformance with the rules of the Michigan Board of Land Surveyors or by a Decree of a Court of Law, established, re-established, monumented, re-monumented, recovered, found as expressed below:

A	B	C	D	E	F	G	H	I	J	K	L	M
2	6	5	4	3	2	1						
3												
4	7	8	9	10	11	12						
5												
6	18	17	16	15	14	13						
7												
8	19	20	21	22	23	24						
9												
10	30	29	28	27	26	25						
11												
12	31	32	33	34	35	36						
13												

NOTE: Not more than 4 corners, all in the same town and range, may be recorded on this certificate.

A. Description of original monument and accessories and/or subsequent restoration:

ORIGINAL MONUMENT: POST SET BY J. MULLET, U.S. DEPUTY SURVEYOR, NOV., 1825. WITNESSED AS: 40.00, SE 1/4 SEC. POST LAND LEVEL WET & SWAMPY BEECH 7 N72-1/2°E 35 BEECH 10 N77-1/2°W 38


DID NOT FIND SUBSEQUENT PUBLIC OR PRIVATE MENTION OF THIS CORNER.

B. Description of corner evidence found and/or method applied in restoring or reestablishing corner:

THE AREA OF THIS PROBABLE LOCATION OF THIS CORNER IS OCCUPIED BY A MUCK AREA BOTH NORTH & SOUTH OF FIVE POINT HIGHWAY. A DEEP DITCH LIES ON THE NORTH SIDE OF THE ROAD. EXCAVATION IN THE AREA OF THE SW CORNER OF SECTION 36 DETERMINED A FILL AREA SIMILAR TO THIS IN LIEU OF MULLETS DESCRIPTION OF TERRAIN AND LACK OF ANY PHYSICAL OR DOCUMENTED EVIDENCE OF THIS CORNER I DEEMED IT A LOST CORNER AND SET A 3/4" X 24" FORM PIN ON LINE BETWEEN M-13 AND L-13, PER THE 1947 MANUAL OF INSTRUCTIONS FOR SETTING A LOST CORNER. THERE WERE NO FENCES FOR EITHER TWP. SET MON. BOX TO BITUMINOUS SURFACE.

C. Description of monument for corner and accessories established to perpetuate locating the position of the corner:

3/4" X 24" FORM PIN WITH A CAP LABELED P. ACT 345 IN MON. BOX CORNER LOCATED 6.4' NORTH OF THE C/L OF FIVE POINT HIGHWAY SET GALV. NAIL & CAP #18994, E/SIDE 10" CHERRY, N03°W, 32.95' SET GALV. NAIL & CAP #18994, S/SIDE TWIN 14" CHERRY, N69°E, 69.13' SET GALV. NAIL & CAP #18994, SW/SIDE 10" ELM, N27°W, 24.89' SET GALV. NAIL & CAP #18994, NW/SIDE 8" WOOD FENCE POST, S52°W, 58.71' MEAS. 2660.18' TO M-13 MEAS. 2660.18' TO K-13

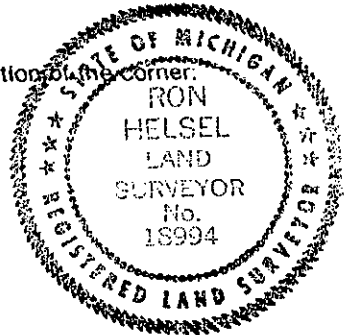

Signed by Ron Helsel Date JULY 28, 1994

Surveyor's Michigan License No. 18994 P.A. 345 EATON COUNTY

PEER APPROVED 7/27/94 M