

FILED

Copy

LAND CORNER RECORDATION CERTIFICATE
Filing Requirement of Act 74, Mich. P.A. 1970

94 JUN -3 AM 11:53

For corners in EATON

(County)

Located In:

EATON
Corner Code #

1. Public Land Survey

T 2N R 4W
T R
T R
T R

M-10

2. Property Controlling in Section

S T R
S T R

3. Miscellaneous Property in Sec.

S T R
S T R

LINDA M. TWITCHELL
REGISTER OF DEEDS
EATON COUNTY, MICH.

LIBER 3 Pg 411

Register of Deeds Stamp & File Number

4. Lot No. , Recorded Plat

5. Private Claims

Grid table with columns A-M and rows 1-13. Contains numbers 1-36 in a grid pattern.

I, RON HELSEL, in a field survey on MARCH 15 & APRIL 19, 19 94

do hereby certify that under requirements of P.A. 74, Michigan P.A. of 1970, the corner points mentioned in lines 1 and 2 above were in conformance with regulations and rules therefore as required in the current manual of survey instructions of the United States Department of the Interior, Bureau of Land Management or by a decree of a Court of Law and/or that the corner points mentioned in lines 3, 4 and 5 above were in conformance with the rules of the Michigan Board of Land Surveyors or by a Decree of a Court of Law; established, re-established, monumented, re-monumented, recovered, found as expressed below:

NOTE: Not more than 4 corners, all in the same town and range, may be recorded on this certificate.

A. Description of original monument and accessories and/or subsequent restoration:

ORIGINAL MONUMENT: MADE CORNER ON BLUE ASH 9 BY SYLVESTER SIBLEY, U.S. DEPUTY SURVEYOR, NOV. 1825. NO WITNESSES.


1). A SURVEY WAS RECORDED IN LIBER 2, PAGE 543, DATED APRIL 5, 1978 BY R. HELSEL #18994. FOUND "T" IRON 4' WEST OF THE C/L OF ROYSTON ROAD. "NO AVAILABLE WITNESSES".

2). A SURVEY WAS RECORDED IN LIBER 4, PAGE 109, DATED MARCH 18, 1986 BY F.N. WHITE #12034. NO DESCRIPTION OR WITNESSES WERE NOTED FOR THE MARKER.

DID NOT FIND FURTHER MENTION OF THIS CORNER IN PUBLIC OR PRIVATE RECORDS.

B. Description of corner evidence found and/or method applied in restoring or reestablishing corner:

FOUND A "T" BAR FENCE POST IN A MON. BOX IN CLOSE ACCORD OF BEING AT THE MIDPOINT BETWEEN M-9 & M-11. EXCAVATED A 4' SQUARE HOLE 2.5' TO 3 FEET DEEP BELOW SAND. AREA APPEARED TO BE A ROAD CUT & COULD NOT FIND ANY SUPPORTING EVIDENCE. LEFT THE POST IN POSITION AND ACCEPTED ITS LOCATION AS A MARKER FOR THE CORNER. SET 3/4" X 24" FORM PIN (EAST SIDE) TO CONFORM WITH P.A. 132.

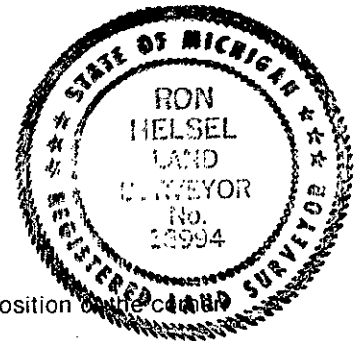

C. Description of monument for corner and accessories established to perpetuate locating the position of the corner:

"T" FENCE POST IN MONUMENT BOX 3'± WEST OF THE C/L OF ROYSTON ROAD
3/4" X 24" IRON FORM PIN & CAP #18994 IN MON. BOX AT A-10, T2N,R3W, (AS RECORDED IN LIBER 3, PAGE 393 OF THE EATON CO. C.R.C.'S) S01°E, 51.88'
FOUND GALV. NAIL & TAG #18994 N/SIDE POWER POLE, S27°E, 79.26'
FOUND GALV. NAIL & TAG #18994 SW/SIDE TWIN 14" WALNUT, N39°E, 112.17'
SET GALV. NAIL & TAG #18994 NE/SIDE 12" ELM, N53°W, 101.27'
SET GALV. NAIL & TAG #18994 E/SIDE 6" ELM, N44°W, 63.76'

Signed by Ron Helsel

Date APRIL 25, 1994

Surveyor's Michigan License No. 18994

P.A. 345 EATON COUNTY
PEER APPROVED 5/25/94