

**SURVEY &  
REMONUMENTATION**

APR 27 1995

**COMMISSION**

**LAND CORNER RECORDATION CERTIFICATE**  
Filing Requirement of Act 74, Mich. P.A. 1970

FILED  
Copy

94 NOV 30 AM 9:11

For corners in

EATON (County)	Located In:	Corner Code #
Carmel Township	T 2N R 5W	L-9
1. Public Land Survey	T _____ R _____	_____
	T _____ R _____	_____
	T _____ R _____	_____
2. Property Controlling in Section	S _____ T _____ R _____	_____
	S _____ T _____ R _____	_____
3. Miscellaneous Property in Sec.	S _____ T _____ R _____	_____
	S _____ T _____ R _____	_____

LINDA M. TWITCHELL  
REGISTER OF DEEDS  
EATON COUNTY, MICH.

LIBER 3 Pg 539  
Register of Deeds Stamp & File Number

4. Lot No. \_\_\_\_\_, Recorded Plat \_\_\_\_\_  
5. Private Claims \_\_\_\_\_

	A	B	C	D	E	F	G	H	I	J	K	L
2	6		5		4		3		2		1	
3												
4	7		8		9		10		11		12	
5												
6	18		17		16		15		14		13	
7												
8	19		20		21		22		23		24	
9												
10	30		29		28		27		26		25	
11												
12	31		32		33		34		35		36	
13												

I, D.L. Clifford, in a field survey on Oct. 22, 1994, do hereby certify that under requirements of P.A. 74, Michigan P.A. of 1970, the corner points mentioned in lines 1 and 2 above were in conformance with regulations and rules therefore as required in the current manual of survey instructions of the United States Department of the Interior, Bureau of Land Management or by a decree of a Court of Law and/or that the corner points mentioned in lines 3, 4 and 5 above were in conformance with the rules of the Michigan Board of Land Surveyors or by a Decree of a Court of Law; established, re-established, monumented, re-monumented, recovered, found as expressed below:

NOTE: Not more than 4 corners, all in the same town and range, may be recorded on this certificate.

A. Description of original monument and accessories and/or subsequent restoration:

- Original Post set by Sylvester Sibley D.S. in Dec. 1825  
Beech 18 N13W 10  
Ironwood 6 S 23 E 22
- Marginal note in the Eaton County Road Commission copy of the GLO notes  
Sugar 8" S70E 62'  
Sugar 8" S44E 26  
Stone 18" down-brick


(OVER)

B. Description of corner evidence found and/or method applied in restoring or reestablishing corner:

Searched at apparent location of corner and found Bolt & Nut 18" deep on centerline Kalamo Highway. Excavated on East side of Bolt and found pointed stone surrounded by brick 0.3' East of bolt. Accepted Stone as perpetuation of corner and drove standard bar in between stone and bolt. Bar is above point of stone and higher than bolt.

C. Description of monument for corner and accessories established to perpetuate locating the position of the corner:  
Standard 3/4" Bar & PA 345 Cap PS 25837 on Centerline Kalamo Highway

- Set Nail & Tag # 25837 in W. Side 10" Walnut NAZ 35° 27.82'
- Set Nail & Tag # 25837 in N.W. Side Anchor post NAZ 183° 19.11'
- Set Nail & Tag # 25837 in S.W. Side 28" Apple NAZ 284° 93.12'
- Set Nail & Tag # 25837 in S. Side 6" Maple NAZ 280° 111.54'
- S.W. Corner House Fdn. NAZ 8° 121.43'

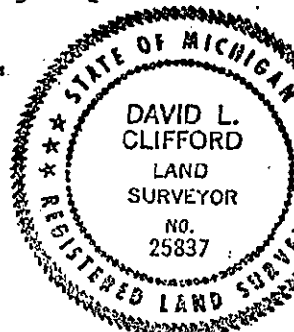

Signed by David Clifford Date Oct. 25, 1994  
Surveyor's Michigan License No. 25837

FORM APPROVED BY MICHIGAN STATE BOARD OF LAND SURVEYORS, JAN. 28, 1988, REVISED MAY 14, 1993, REVISED JAN. 1994

P.A. 345 EATON COUNTY  
DEED APPROVED 10/26/94 ML

3. Another marginal note in the Eaton County Road Commission copy of the GLO notes  
Located 12/20/56  
Set 5/8" X 18" Bolt 0.3' West of stone  
Apple 18" N31W 26.00'  
Apple 22" N39W 45.00'  
F.A. Fisher Reg. Surv. #3102
4. Eaton County Road Commission Grid Map  
Stone, Brick & Iron ( $\frac{1}{2}$ " Rod)  
8" Maple ESE 62.0'  
8" Maple SE 26.0'  
18" Apple NW 26.0'  
22" Apple NW 45.0'
5. R. Reed LS #19004 used corner in surveys recorded in Liber 1 of surveys page 995 & 997 as an iron bar in center gravel road. Survey was performed in October 1975.  
16" Maple SSW 20'  
16" Maple SSE 60.7"  
Anchor Post South 18.9'
6. R. Reed again used corner in a survey recorded in Liber 4 of surveys page 987 as a 1" pipe. Survey was performed in May 1990.  
Tag in North side anchor post South 18.6'  
Tag in West side 10" Walnut NNE 28'  
Tag in S. side 21" Apple Stump WNW 67.7'