

DEC 12 1997

97 NOV 24 AM 10:27

COMMISSION

LAND CORNER RECORDATION CERTIFICATE  
Filing Requirement of Act 74, Mich. P.A. 1970

For corners in

LINDA M. TWITCHELL  
REGISTER OF DEEDS  
EATON COUNTY, MICH.

<u>EATON COUNTY</u>	Located In:	Corner Code #
(County)		
CARMEL TOWNSHIP		
1. Public Land Survey	T <u>2N</u> R <u>5W</u>	<u>M-12</u>
	T _____ R _____	_____
	T _____ R _____	_____
	T _____ R _____	_____
Property Controlling	S _____ T _____ R _____	_____
in Section	S _____ T _____ R _____	_____
3. Miscellaneous	S _____ T _____ R _____	_____
Property in Sec.	S _____ T _____ R _____	_____

Copy  
Libr 3 pg 840

Register of Deeds Stamp & File Number

4. Lot No. \_\_\_\_\_, Recorded Plat \_\_\_\_\_  
5. Private Claims \_\_\_\_\_

I, DAVID L. CLIFFORD, in a field survey on SEPTEMBER 30, 1997  
do hereby state that under requirements of P.A. 74, Michigan P.A. of 1970, the corner points mentioned in lines 1 and 2 above were in conformance with regulations and rules therefore as required in the current manual of survey instructions of the United States Department of the Interior, Bureau of Land Management or by a decree of a Court of Law and /or that the corner points mentioned in lines 3, 4 and 5 above were in conformance with the rules of the Michigan Board of Land Surveyors or by a Decree of a Court of Law; established, re-established, monumented, recovered, found as expressed below:

NOTE: Not more than 2 corners, all in the same town and range, may be recorded on this certificate.

A	B	C	D	E	F	G	H	I	J	K	L	M
1												
2	6	5	4	3	2	1						
3												
4	7	8	9	10	11	12						
5												
6	18	17	16	15	14	13						
7												
8	19	20	21	22	23	24						
9												
10	30	29	28	27	26	25						
11												
12	31	32	33	34	35	36						
13												

A. Description of original monument and accessories and/or subsequent restoration:

1. JOHN MULLET D.S. SET ORIGINAL CORNER IN NOVEMBER 1824; BEECH 6" S29°W 28 LKS, DO 6" N58°W 14 LKS.
2. THERE IS NO OTHER MENTION OF THE CORNER IN THE EATON COUNTY PUBLIC RECORDS
3. LARRY BRYAN PS #25832 SET A CAP IN A DRILL HOLE HALF WAY BETWEEN THE SECTION CORNERS AND ON THE TOWNSHIP LINE IN AN ACT 132 SURVEY IN AUGUST 1997: FOUND NAIL & TAG #25832 IN TOP GUARD RAIL POST, S40°E, 30.43', FOUND 1/2" BAR IN MONUMENT BOX, SOUTH, 20.03', FOUND NAIL & TAG #16053 IN TOP GUARD RAIL POST, N85°E, 26.91', FOUND NAIL & TAG IN TOP GUARD RAIL POST, S45°E, 34.94'.

B. Description of corner evidence found and/or method applied in restoring or reestablishing corner:

SEARCHED AT APPARENT LOCATION OF CORNER AND FOUND CAP #25832, IN A DRILL HOLE, 1.5 FEET WEST OF CENTERLINE COCHRAN ROAD AND 20.06' NORTH OF A-12, T2N, R4W MATCHING ALL OF L. BRYAN'S WITNESSES. DID NOT EXCAVATE BECAUSE CORNER IS IN 30' OF FILL FOR I-69 OVERPASS. ACCEPTED CAP AS CORNER AS PERPETUATED BY LARRY BRYAN. DRILLED HOLE IN CONCRETE SURFACE OF COCHRAN ROAD AND SET STANDARD BAR & CAP. BRYAN LAND SURVEYS GPS TRAVERSE OF SECTION 36, T2N R5W SHOW CORNER TO BE ON THE STANDARD LINE. BRYAN LAND SURVEYS MEASURED NORTH 2664.01' TO M-11 AND SOUTH 2664.01' TO M-13.


C. Description of monument for corner and accessories established to perpetuate locating the position of the corner:

M-12 T2N, R5W  
3/4' BAR & ORANGE PLASTIC CAP IMPRINTED PA 345 PS 25837 1.5' WEST OF CENTERLINE COCHRAN ROAD  
1/2" BAR & CAP (M-12, T2N, R5W) IN MONUMENT BOX, 180° NAZ, 20.06'  
FOUND NAIL & TAG #16053 (JIM STEPHENS) IN TOP GUARD RAIL POST, 84° NAZ, 26.93'  
FOUND NAIL & TAG #25832 IN TOP GUARD RAIL POST, 229° NAZ, 30.43'  
FOUND 60D SPIKE IN TOP GUARD RAIL POST, 129° NAZ, 35.00'  
NE CORNER BRIDGE ABUTMENT, 146° NAZ, 50.08'  
NW CORNER BRIDGE ABUTMENT, 194° NAZ, 92.03'

Signed by David L. Clifford  
Surveyor's Michigan License No. 25837

Date OCTOBER 11, 1997

FORM APPROVED BY MICHIGAN STATE BOARD OF PROFESSIONAL SURVEYORS.  
JAN. 28, 1971  
REVISED MAY 14, 1975  
REVISED JAN., 1983  
REVISED OCT., 1985

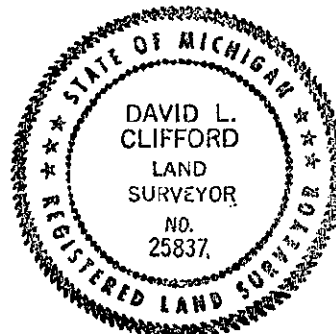

P.A. 345 EATON COUNTY  
PEER APPROVED 10/14/97 M