

REMONUMENT

FILED

DEC 1 2 1997

LAND CORNER RECORDATION CERTIFICATE
Filing Requirement of Act 74, Mich. P.A. 1970

97 OCT 23 PM 1:26

COMMISSION

For corners in

<u>EATON</u> (County)	Located In:	Corner Code #
	KALAMO	TOWNSHIP
1. Public Land Survey	T <u>2N</u> R <u>6W</u>	<u>A-5</u>
	T _____ R _____	_____
	T _____ R _____	_____
	T _____ R _____	_____
2. Property Controlling in Section	S _____ T _____ R _____	_____
	S _____ T _____ R _____	_____
3. Miscellaneous Property in Sec.	S _____ T _____ R _____	_____
	S _____ T _____ R _____	_____

LINDA M. TWITCHELL
REGISTER OF DEEDS
EATON COUNTY, MICH.

Liber 3 pg 826

Register of Deeds Stamp & File Number

4. Lot No. _____, Recorded Plat _____
5. Private Claims _____

M-5 BARRY COUNTY
MAPLE GROVE TOWNSHIP T2N, R7W

I, RON HELSEL, in a field survey on SEPT. 12, 1997, do hereby certify that under requirements of P.A. 74, Michigan P.A. of 1970, the corner points mentioned in lines 1 and 2 above were in conformance with regulations and rules therefore as required in the current manual of survey instructions of the United States Department of the Interior, Bureau of Land Management or by a decree of a Court of Law and /or that the corner points mentioned in lines 3, 4 and 5 above were in conformance with the rules of the Michigan Board of Land Surveyors or by a Decree of a Court of Law; established, re-established, monumented, re-monumented, recovered, found as expressed below:


	A	B	C	D	E	F	G	H	I	J	K	L
1												
2	6	5	4	3	2	1						
3												
4	7	8	9	10	11	12						
5												
6	18	17	16	15	14	13						
7												
8	19	20	21	22	23	24						
9												
10	30	29	28	27	26	25						
11												
12	31	32	33	34	35	36						
13												

NOTE: Not more than 4 corners, all in the same town and range, may be recorded on this certificate.

A. Description of original monument and accessories and/or subsequent restoration:
 ORIGINAL MONUMENT: POST SET BY, JOHN MULLETT U.S. DEPUTY SURVEYOR, 1825. WITNESSED AS: BEECH 7", S45W, 38 LINKS & BEECH 7", N59W, 14 LINKS IN A SURVEY OF T2N, R7W, BARRY COUNTY. MUSGROVE EVANS, U. S. DEPUTY SURVEYOR, INTERSECTED THE ORIGINAL POST IN THE ORIGINAL SURVEY OF KALAMO TOWNSHIP, MAY 19, 1826. HE WITNESSED THE POST AS: SUGAR 9", S51E, 12 LINKS & SUGAR 22", N58E, 25 LINKS, 82.31 CHAINS FROM THE NE CORNER OF SECTION 18.
 1) COUNTY SURVEYOR, J. H. GIBBONS, NOV. 4-6, 1868, VOL. 1, PAGE 25, CALLED FOR A STONE AND 2 OLD BEARING TREES, WITNESSED AS: W. OAK 44", S13W, 17 1/2 LINKS.
 2) MARGINAL NOTE IN THE EATON COUNTY ROAD COMM. COPY OF THE G.L.O. NOTES, ALONG WITH A LOOSE NOTE IN THE REGISTER OF DEEDS COPY OF THE G.L.O. NOTES AND RESEARCH NOTES PROVIDED BY P.S. B. REYNOLDS NO. 31602 IN BARRY COUNTY, CALLED FOR A 3/4" STEEL PIN AT "SECTION CORNER COMMON TO SEC.'S 12 & 13 BARRY & 7 & 18 EATON. SEC. CORNER NOT FOUND BUT WAS RE-ESTABLISHED IN 1954 BY HIGHWAY SURVEY CHIEF D. C. PYLE; 1959 HIGHWAY PLANS, PAGE 9."
 (CONTINUED ON BACK)

B. Description of corner evidence found and/or method applied in restoring or reestablishing corner:
 FOUND THE BOLT SPIKE IN A MONUMENT BOX 0.5 FEET NORTH OF THE CENTERLINE OF M-79, 5 FEET EAST OF THE CENTERLINE OF CURTIS RD. TO THE NORTH AND 4 FEET WEST OF THE CENTERLINE OF CURTIS ROAD TO THE SOUTH. EXCAVATED DOWN THROUGH THE MONUMENT BOX AND FOUND THE BOLT SPIKE POSITIONED ON THE EAST SIDE OF AND WEDGED BETWEEN YELLOW FIRE BRICK AND A SMOOTH BLUE STONE, 1.5 FEET DEEP. ± MEASUREMENT TO THE 1/4 CORNER COMMON TO SECTIONS 7 AND 18 (B-5) AS RECORDED IS WITHIN 2 FEET OF THE HIGHWAY STATIONING, AND WITHIN 20 FEET OF COUNTY SURVEYOR GIBBONS MEASUREMENT. DID NOT MATCH THE G.L.O. MEASUREMENT BY M. EVANS BY 260 FEET, WHICH APPEARS TO BE CONSISTENT WITH THE PREVIOUS FINDINGS ALONG THE BARRY AND EATON CO. LINE BY SURVEYORS B. REYNOLDS AND D. LOHR, P.S. NO. 30090 WHILE CONDUCTING REMONUMENT WORK UNDER P. A. 345. ACCEPTED THE POSITION OF THE BOLT SPIKE AS FAITHFUL PERPETUATION OF THE CORNER AND SET A 3/4" X 24" FORM PIN AND CAP STAMPED P.A. 345 P.S. NO. 18994 TO GRADE IN THE MON. BOX.

C. Description of monument for corner and accessories established to perpetuate locating the position of the corner:
 3/4" PIN AND CAP IN MON. BOX 0.5' NORTH CENTER LINE OF M-79
 CENTER OF M-DOT BRASS MARKER IN CONC. MONUMENT, AZ. 314°, 75.51 FEET
 FOUND NAIL AND TAG NO. 18988, NW/SIDE T. POLE, AZ. 35°, 56.64 FEET
 FOUND NAIL AND TAG NO. 18988, NE/SIDE T. POLE, AZ. 155°, 60.54 FEET
 FOUND FILED "X" IN GUARD RAIL BOLT HEAD AT WEST END OF RAIL, AZ. 115°, 60.29 FEET
 FOUND FILED "X" IN GUARD RAIL BOLT HEAD AT WEST END OF RAIL, AZ. 33°, 48.52 FEET

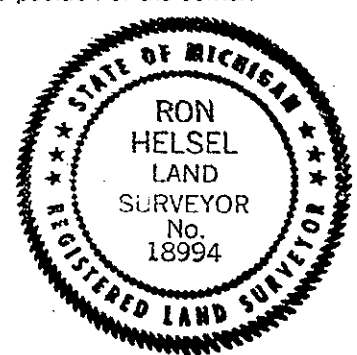

Signed by Ron Helsel Date 9-18-97
 Surveyor's Michigan License No. 18994

2) CONTINUED

WITNESSED AS: TAG IN 23" MAPLE, N39°E, 46.14'
TAG IN 22" ELM, N51°E, 54.72'
TAG IN TELEPHONE POLE, S51°E, 55.97'

3) EATON COUNTY ROAD COMM. GRID MAP CALLS FOR THE SAME MONUMENT AND WITNESSES AS ABOVE.

4) A 280 CARD ON FILE AT THE OFFICE OF F. N. WHITE, P.S. NO. 12034 CALLED FOR THE SAME WITNESSES AS 2-A ABOVE.

4) L.C.R.C.'S WERE RECORDED IN LIBER 1, PAGE 450 BARRY COUNTY RECORDS, FIELD DATED OCTOBER, 1989, DATED MAR. 16, 1992 AND IN LIBER 3, PAGE 187, EATON COUNTY RECORDS, FIELD DATED OCTOBER, 1989, DATED MAR., 12, 1992, BY K. D. FLUKE P.S. NO. 18988. *FOUND CORNER AS CALLED FOR IN MDOT PLANS DATED 1959, PROJ. 23-36, BOAT SPIKE IN MON. BOX. THIS CORNER IS COMMON TO SECTIONS 7 AND 18, T2N-R6W AND SECTIONS 12 AND 13, T2N-R7W.*

WITNESSED AS: BOAT SPIKE IN MON. BOX (FOUND)

S30E-60.52-TELEPHONE POLE (FOUND NAIL AND TAG NO. 18988)

S55E-60.30-CROSS ON BOLT HEAD, AT WEST END OF GUARD RAIL (FOUND "X")

N66E-43.52-CROSS ON BOLT HEAD, AT WEST END OF GUARD RAIL (FOUND "X")

N47E-56.65-TEL. POLE (FOUND NAIL AND TAG NO. 18988)

Liber 3 pg 827