

SURVEY & REMONUMENTATION

FILED

DEC 1 6 1996

EATON COUNTY REMONUMENTATION

COPY

96 OCT 28 AM 9: 21

COMMISSION

LAND CORNER RECORDATION CERTIFICATE

Filing Requirement of Act 74, Mich. P.A. 1970

For corners in **EATON**

(County)

Located In:

Corner Code #

1. Public Land Survey CORNER COMMON TO SECTIONS 19 & 30 ON RANGE LINE KALAMO TOWNSHIP

T 2N R 6W

A-9

2. Property Controlling in Section


S T R

3. Miscellaneous Property in Sec.

S T R

4. Lot No. Recorded Plat

5. Private Claims

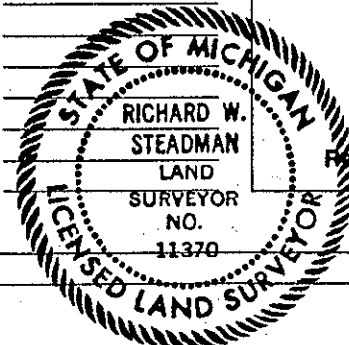

LINDA M. TWITCHELL REGISTER OF DEEDS EATON COUNTY, MICH.

Liber 3, pg. 715

Register of Deeds Stamp & File Number

RICHARD W. STEADMAN

OCTOBER 9

19 96

I, in a field survey on, do hereby certify that under requirements of P.A. 74, Michigan P.A. of 1970, the corner points mentioned in lines 1 and 2 above were in conformance with regulations and rules therefore as required in the current manual of survey instructions of the United States Department of the Interior, Bureau of Land Management or by a decree of a Court of Law and/or that the corner points mentioned in lines 3, 4 and 5 above were in conformance with the rules of the Michigan Board of Land Surveyors or by a Decree of a Court of Law; established, re-established, monumented, re-monumented, recovered, found as expressed below:

NOTE: Not more than 4 corners, all in the same town and range, may be recorded on this certificate.

A. Description of original monument and accessories and/or subsequent restoration:

- 1. GENERAL LAND OFFICE DEPUTY SURVEYOR MUSGROVE EVANS, 1826, AT 81.17 CH. INTERSECT W. BDRY 15 LKS. SOUTH OF POST, SET POST COR. SECS. 19 & 30. 12" SUGAR S69 1/2E 20" LYNN N42E 50
2. COUNTY SURVEYOR OSCAR G. CHURCH: 9-26-1876,(VOL. 2, P. 37) "STONE & C. SET FROM MAPLE GROVE CORNER" NO WITNESSES GIVEN.
3. CORRESPONDING STANDARD CORNER WAS RECORDED BY DOUGLAS W. BONNEMA, PS # 12579, BARRY COUNTY LCRC #462, RECORDED SEPT. 14, 1992, "FOUND 1/2" REROD...ACCEPTED 1/2" REROD AS FOUND..."

B. Description of corner evidence found and/or method applied in restoring or reestablishing corner:

FOUND 1/2" IRON REPRESENTING STANDARD CORNER AS PER LCRC #462 (ITEM #3 ABOVE). CONFIGURATION OF ROADS MADE IT UNCLEAR WHETHER THE IRON WAS INTENDED TO REPRESENT THE STANDARD OR CLOSING CORNER. TRAVERSED 2 1/2 MILES OF RANGE LINE FROM A-13 TO A 8, AND ENOUGH OF SECTION 30, TYING IN OCCUPATION LINES APPARENTLY BASED ON CHURCH'S SURVEY (ITEM 3 ABOVE) AND "BACKED IN" POSITION OF CLOSING CORNER BASED ON THOSE MEASUREMENTS. CLOSING CORNER FELL 10+/- FEET SOUTH OF IRON RECORDED BY BONNEMA. EXCAVATED WITH BACKHOE AN AREA 20' N-S BY 10' E-W TO A DEPTH OF 4+ FEET IN SEARCH OF OTHER MONUMENTATION FOR BOTH STANDARD AND CLOSING CORNERS, FOUND NOTHING. ACCEPTED CORNER POSITION RECORDED BY BONNEMA AS BEST AVAILABLE EVIDENCE OF STANDARD CORNER POSITION. SET EATON COUNTY REMON MONUMENT 9.90 FEET SOUTH OF M-9 T2N R7W, AS PER GLO NOTES (ITEM #1 ABOVE) AND AS IMPLIED BY CHURCH'S NOTES (ITEM #2 ABOVE). FIELD WORK SUPERVISED BY BRIAN REYNOLDS, PS #31602.

C. Description of monument for corner and accessories established to perpetuate locating the position of the corner:

SET STANDARD EATON COUNTY REMONUMENTATION MONUMENT (3/4" X 24" SOLID IRON WITH PLASTIC CAP INSCRIBED "PA 345 PS11370") FOUND PK NAIL IN THE SE SIDE OF RAILROAD TIE CORNER POST N32°E 45.31' FOUND PK NAIL IN THE NW SIDE OF UTILITY POLE S71°W 69.87' SET 1/2" CAPPED IRON CAP INSCRIBED "REYNOLDS TRAVERSE POINT" N70°W 73.81' SET 1/2" CAPPED IRON CAP INSCRIBED "REYNOLDS TRAVERSE POINT" S85°W 73.03' M-9 T2N R7W (BARRY COUNTY REMON MONUMENT 3/4"x24" SOLID IRON W/ALUMINUM CAP) NORTH 9.90' 10+/- FEET SOUTH OF C/L E-W ROAD 3+/- FEET EAST OF C/L N-S ROAD

Signed by Richard W. Steadman

Date October 17, 1996

Surveyor's Michigan License No. 11370

P.A. 345 EATON COUNTY PEER APPROVED 10/17/96 RW

Grid table with columns A-M and rows 2-13, containing numbers 1-36.