

**SURVEY &  
REMONUMENTATION**

DEC 16 1996

COMMISSION

**LAND CORNER RECORDATION CERTIFICATE  
Filing Requirement of Act 74, Mich. P.A. 1970**

96 OCT 28 AM 9: 23

FILED

Copy

For corners in  
EATON COUNTY  
(County)

Located In:

Corner Code #

Kalamo Township

1. Public Land Survey	T	<u>2N</u>	R	<u>6W</u>	<u>B-13</u>
	T	_____	R	_____	_____
	T	_____	R	_____	_____
	T	_____	R	_____	_____
2. Property Controlling in Section	S	_____	T	_____	R
	S	_____	T	_____	R
3. Miscellaneous Property in Section	S	_____	T	_____	R
	S	_____	T	_____	R

LINDA M. TWITCHELL  
REGISTER OF DEEDS  
EATON COUNTY, MICH.

Liber 3, Pg. 719

Register of Deeds Stamp & File Number

4. Lot No. \_\_\_\_\_, Recorded Plat \_\_\_\_\_  
5. Private Claims \_\_\_\_\_

A	B	C	D	E	F	G	H	I	J	K	L	M
2	6	5	4	3	2	1						
3												
4	7	6	5	4	3	2	1					
5												
6	18	17	16	15	14	13	12	11	10	9	8	7
7												
8	19	18	17	16	15	14	13	12	11	10	9	8
9												
10	30	29	28	27	26	25	24	23	22	21	20	19
11												
12	31	30	29	28	27	26	25	24	23	22	21	20
13												

I, R. W. Steadman, in a field survey on August 6, 19 96, do hereby certify that under requirements of P.A. 74, Michigan P.A. of 1970, the corner points mentioned in lines 1 and 2 above were in conformance with regulations and rules therefore as required in the current manual of survey instructions of the United States Department of the Interior, Bureau of Land Management or by a decree of a Court of Law and/or that the corner points mentioned in lines 3, 4 and 5 above were in conformance with the rules of the Michigan Board of Professional Surveyors or by a Decree of a Court of Law; established, re-established, monumented, re-monumented, recovered, found as expressed below:

NOTE: Not more than 4 corners, all in the same town and range, may be recorded on this certificate.

A. Description of original monument and accessories and/or subsequent restoration:

- 1). 5-20-1825: U. S. Public Land Survey Field Notes, John Mullett, Deputy Surveyor set 1/4 Section Post; 9" Oak N52°E 19 links, 6" Beech N32°W 24 links.
- 2). 1973: Private records of D. J. Davis, L.P.S. 17617, "S. 1/4 Post 5/8" iron, 30" Maple N80°E 114.9 feet, Utility Pole S60°W 103.4 feet, 122 feet East of old school house".

The map of Kalamo Township in Ogle's 1913 Atlas of Eaton County shows ownership on both of the N-S 1/4 line by the same party.


B. Description of corner evidence found and/or method applied in restoring or reestablishing corner:

Examined the approximate corner location, but found no evidence of monumentation, accessories, or occupation. Determined the corner to be lost, and re-established it by single proportionate measure. The U. S. distance A-13 to C-13 is 84.70 chains (5590.20 feet)., which I measure to be 5617.32 feet. By proportion the distance from A-13 to B-13 is 2964.51 feet and the distance from B-13 to C-13 is 2652.81 feet. Set standard Eaton County Remonumentation iron rod and cap in monument box to mark the corner, which falls about 7.8 feet north of the centerline of the pavement on Five Point Hwy

C. Description of monument for corner and accessories established to perpetuate locating the position of the corner:

Set 3/4" smooth iron rod and cap stamped "P. A. 345, PS 11370" in monument box and took the following witnesses (bearings are magnetic):

- Set 5/8" iron rod and cap 11370 N71°W 33.00 feet
- Set 5/8" iron rod and cap 11370 N82°E 33.00 feet
- Set 5/8" iron rod and cap 11370 S41°E 33.00 feet
- Set 5/8" iron rod and cap 11370 S52°W 32.29 feet
- Additional current witness provided by Brian Reynolds, L.P.S. 31602: Nail and tag 31602 set in Utility Pole S58°W 105.03 feet.

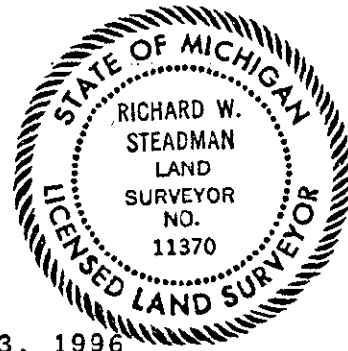

Signed by Richard W. Steadman

Date September 23, 1996

Surveyor's Michigan License No. 11370

FORM APPROVED BY MICHIGAN STATE BOARD OF PROFESSIONAL SURVEYORS, JAN. 26, 1971  
REVISED MAY 14, 1975  
REVISED JAN., 1983

P.A. 345 EATON COUNTY  
PEER APPROVED 10/17/96 RL